COUNTY SURVEYOR
RECORD 2 1869-1900

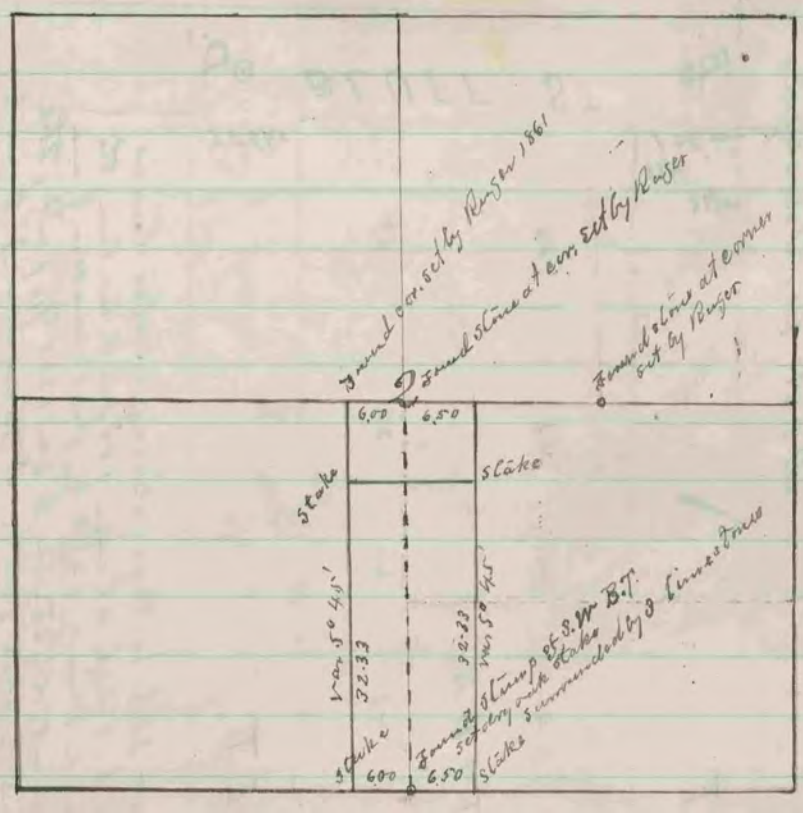

The above is a plat and record of a survey made by me June 8th 1880 on Section 2 Turtle.

R. K. Lee, Dep't C. Surveyor.

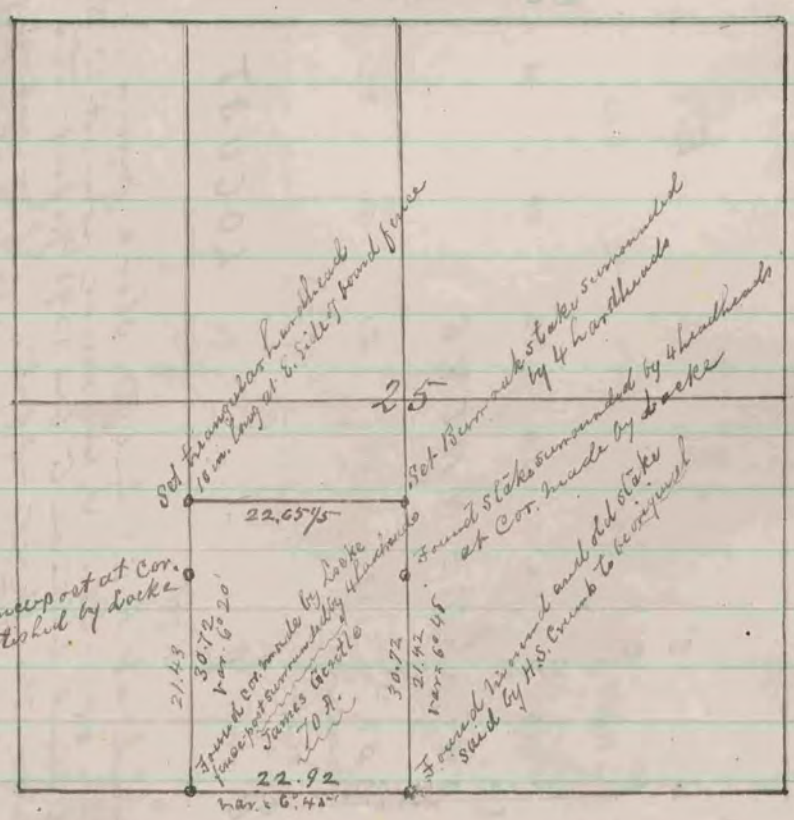

The above is Plat and record of a Survey made by me June 10th 1880 on Section 25 Johnstown.

R. K. Lee

Dep't Co. Surveyor.