COUNTY SURVEYOR
RECORD 2 1869-1900

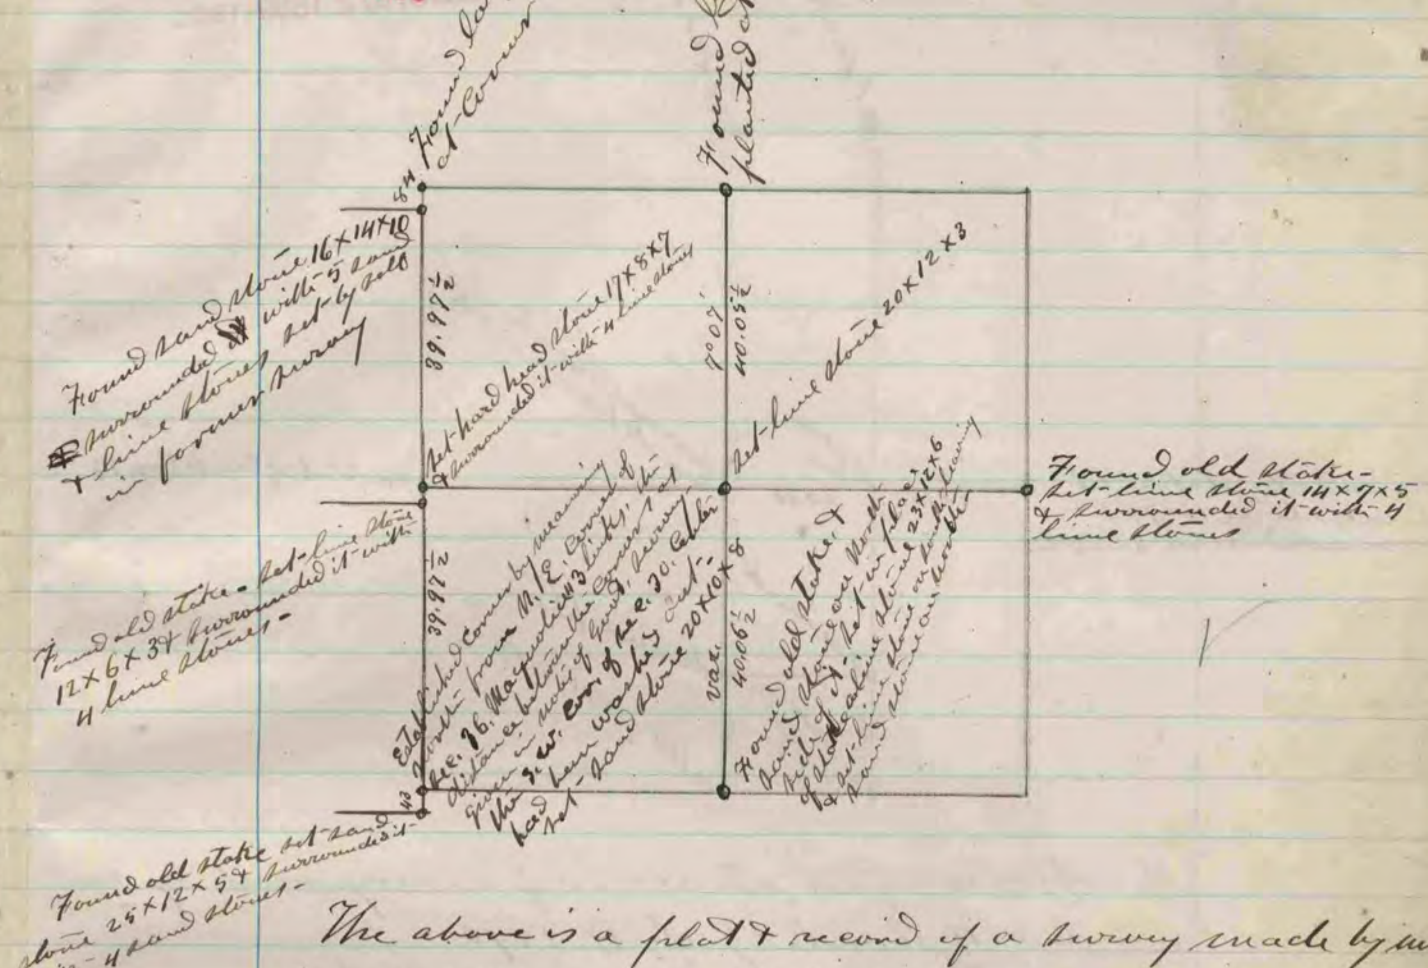


The above is a plat & record of a survey made by me
July 7. 1870, on Section 30 Center
Edward Ruger
Dept. Co. Surveyor

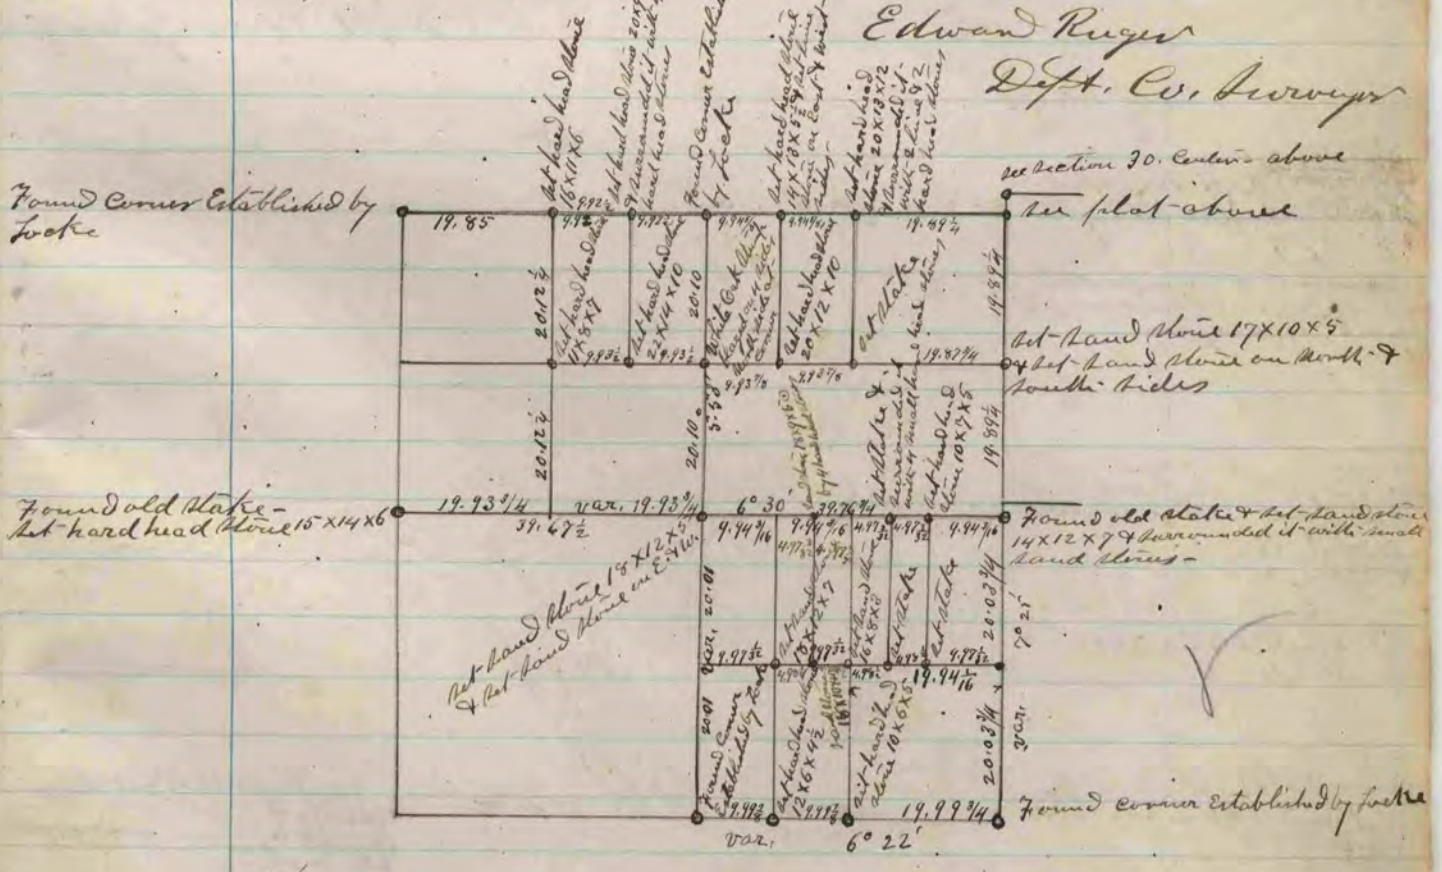


The above is a plat & record of a survey made by me
July 8 & 9 1870, on Section 36 Magnolia
Edward Ruger
Dept. Co. Surveyor