COUNTY SURVEYOR
RECORD 2 1869-1900

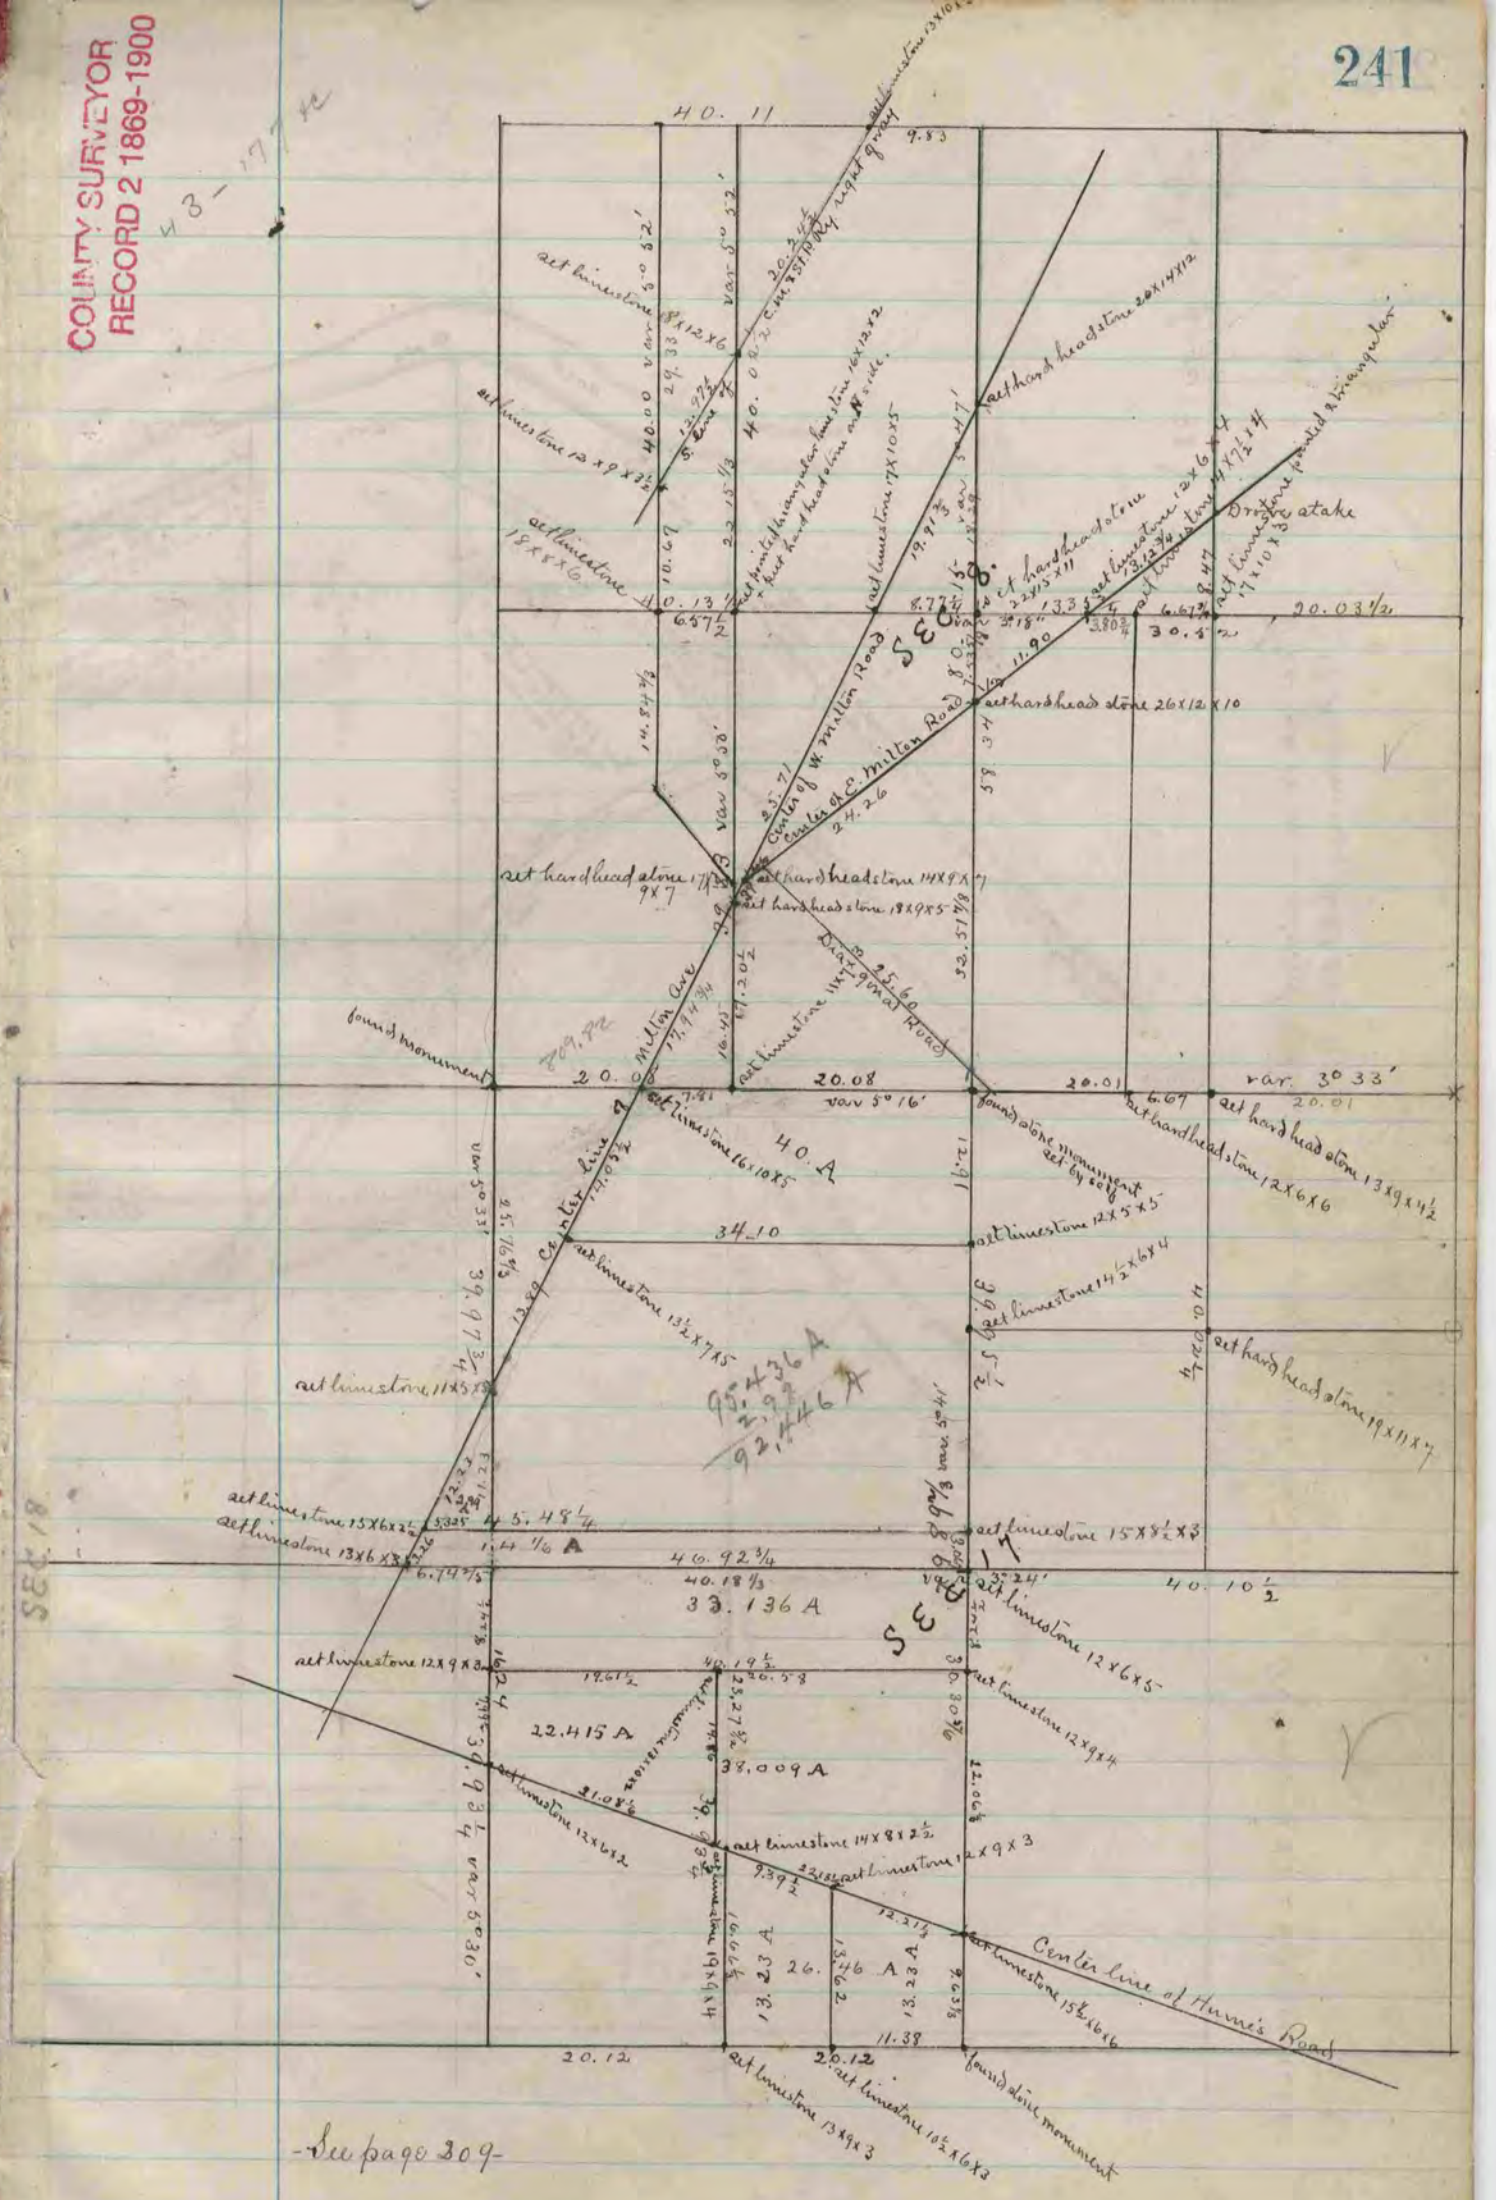

-See page 309-

The above is a record & plat of a survey made by me on Sections 8, 17, Harmony and the East half of Sec. 18. Sept. 1-10, 1886.

Edward Ruger County Surveyor