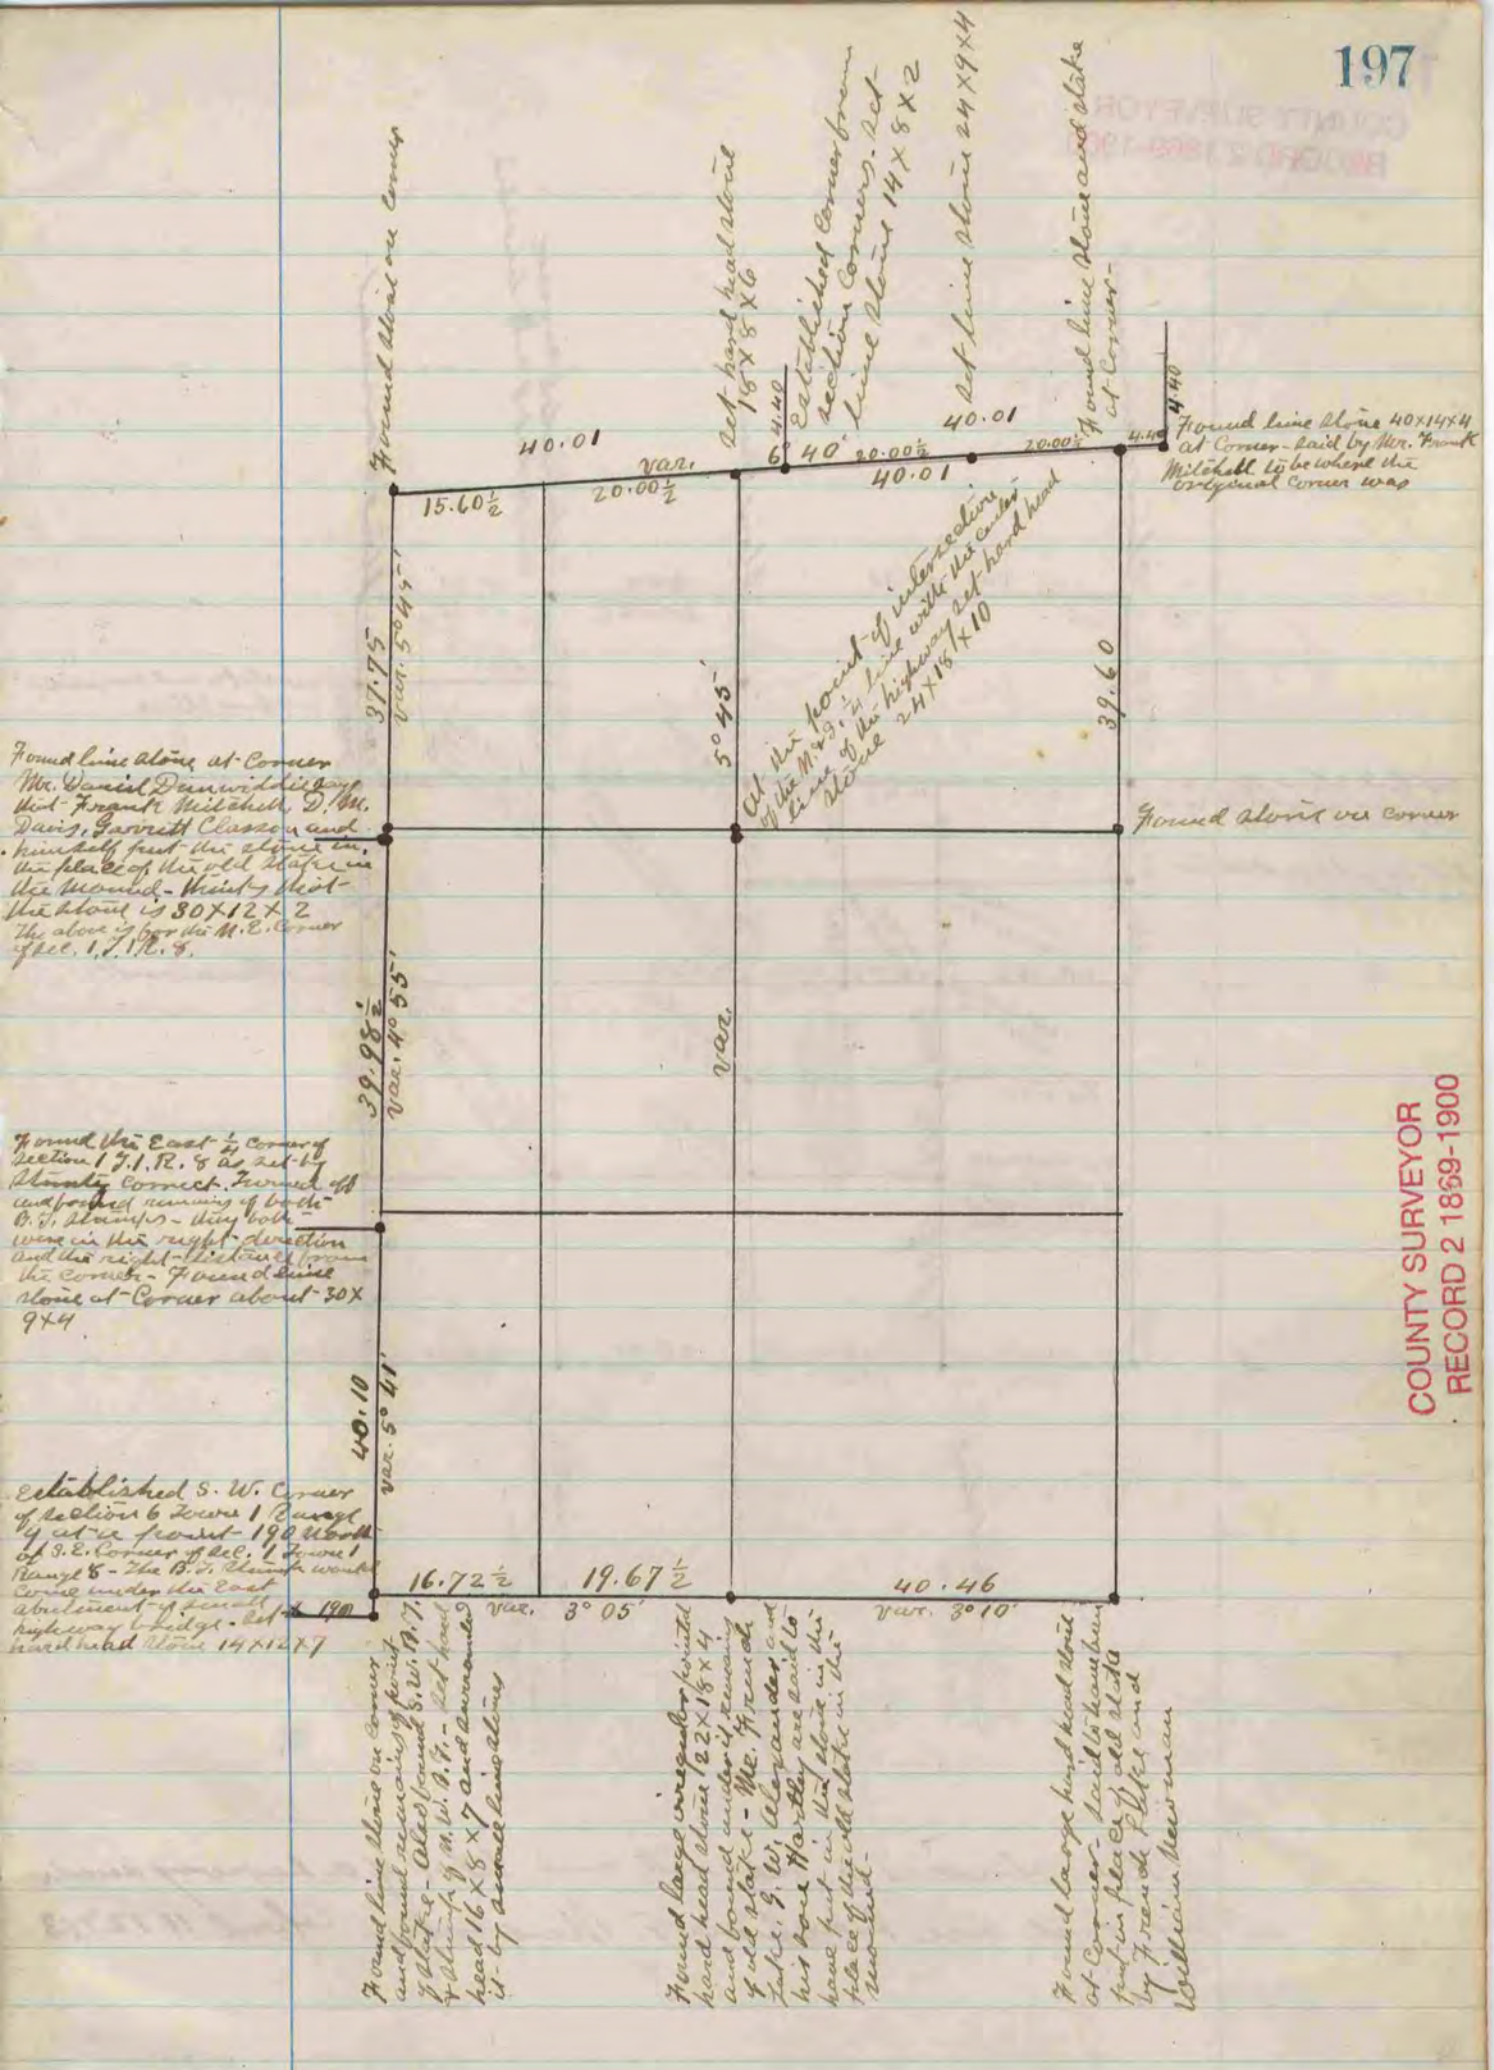

The above is a record and plat of a survey made by me on Sec. 6 Town 1 Range 9 - Green County. March 18 & 19 — 1878

Edward Ruger

County Surveyor

COUNTY SURVEYOR
RECORD 2 1869-1900