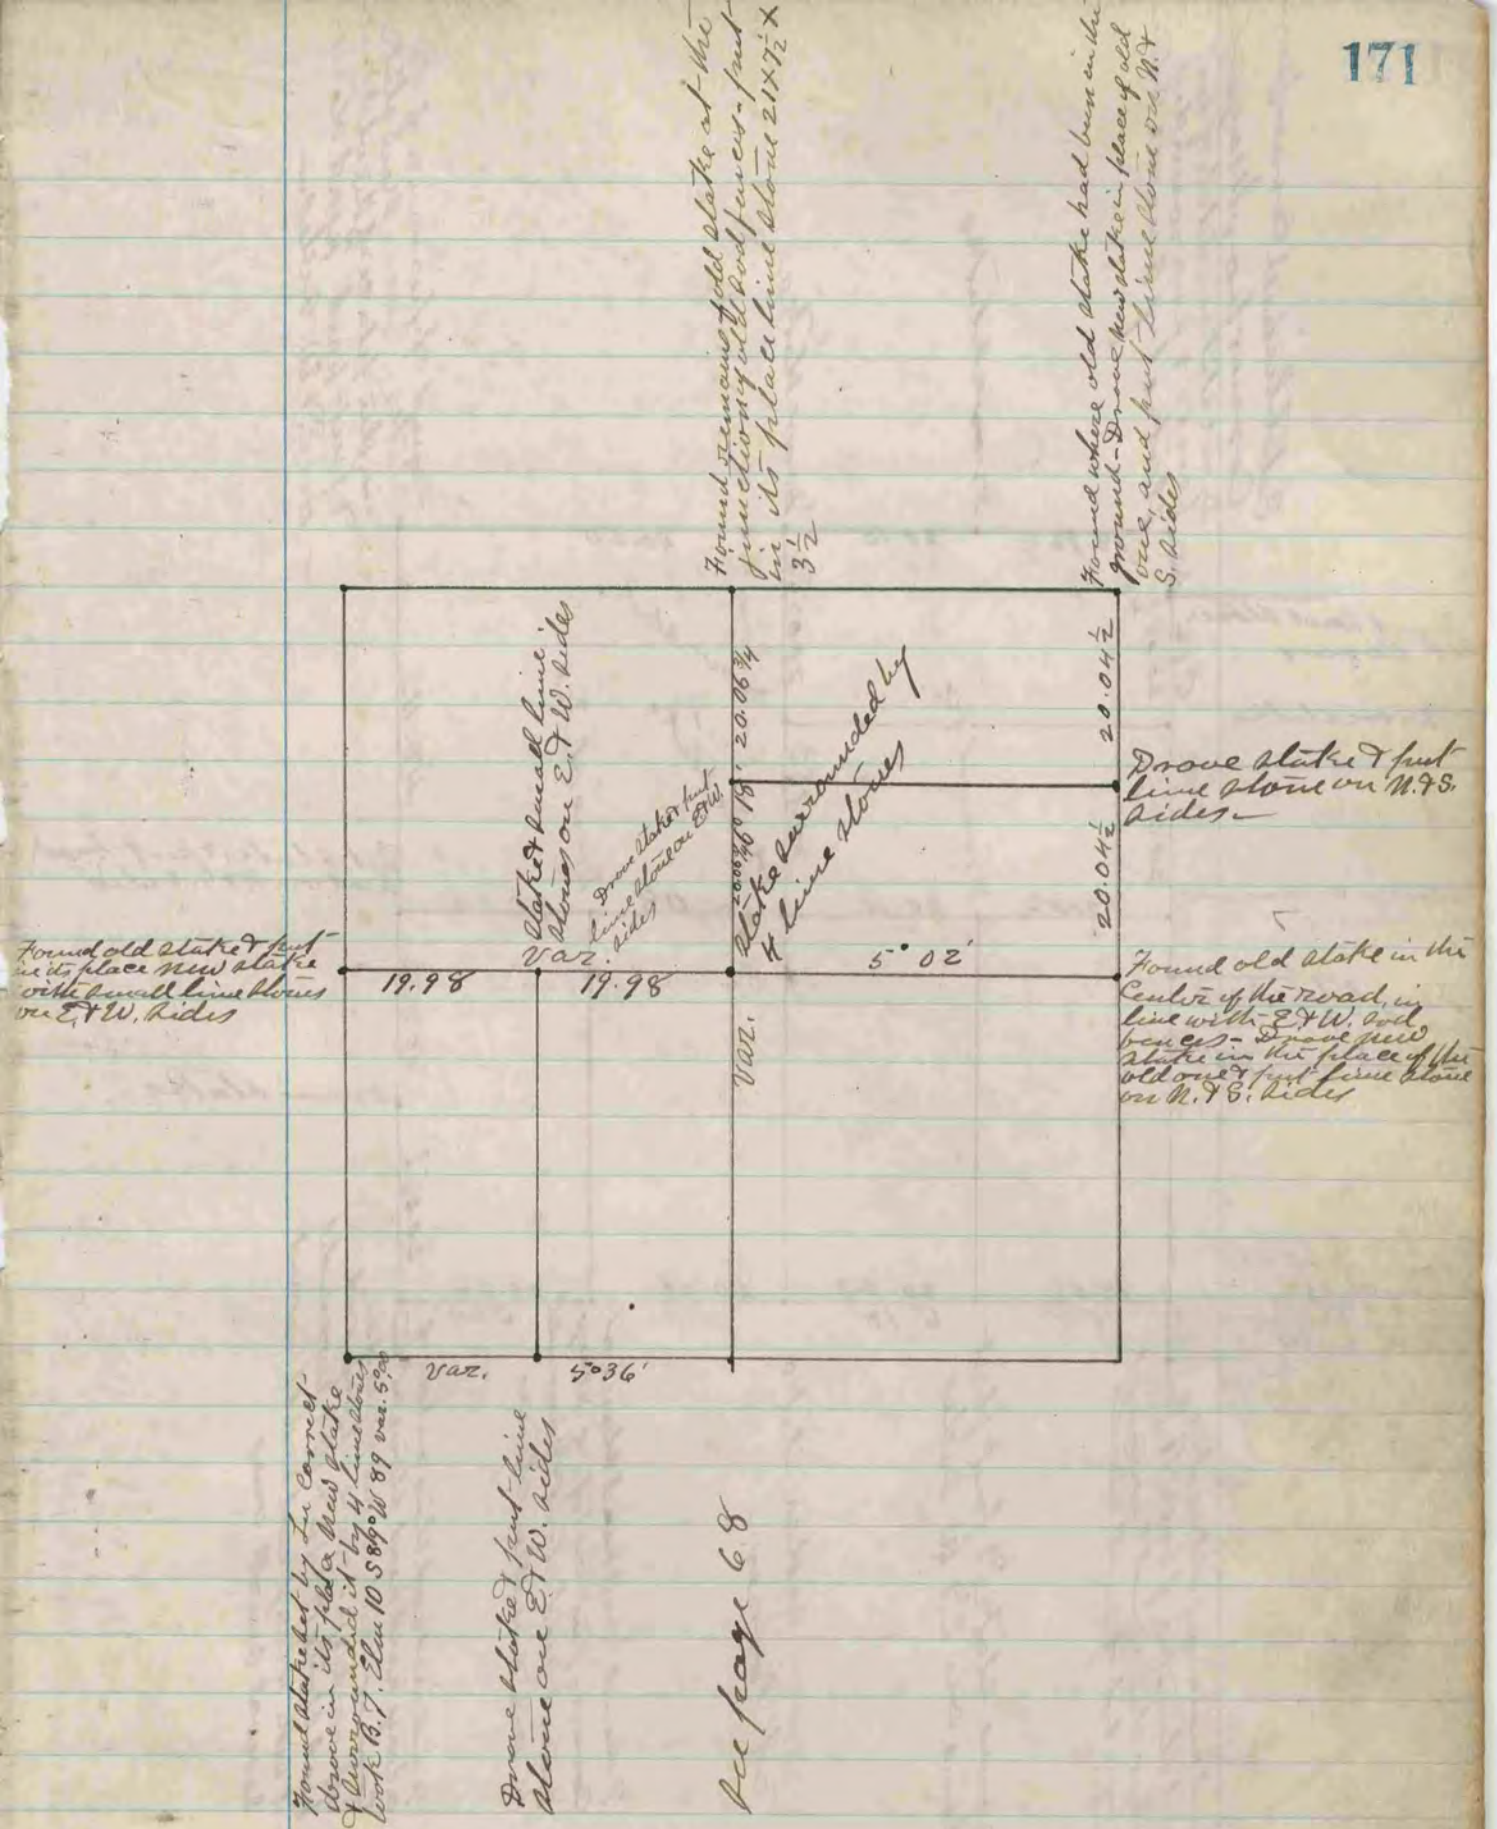

The above is a record and plat of a survey made by me on Section 23 Rock - Sept. 25 - 1876

Edward Ruger
County Surveyor

COUNTY SURVEYOR
RECORD 2 1869-1900