67


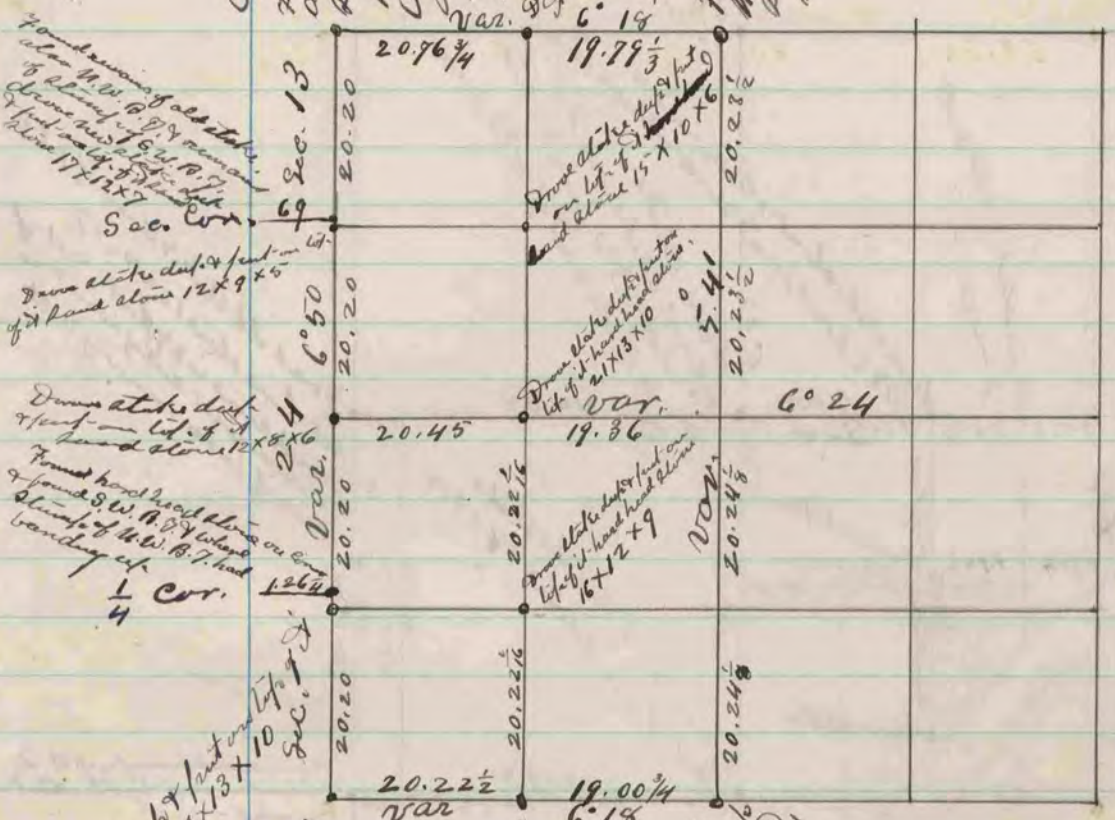
Sec. Cor.
1/4 Cor.
Sec. 13
Sec. 24
20.76¾
19.79⅓
20.45
19.86
20.22½
19.00¾
20.20
20.23½
20.24⅛
6° 18'
6° 50
6° 24
5° 41'
Var.
Found remains of old stone Sec. Cor. 69
Found S.W. B.T. & Chimney & N.W. B.T. bearing E. & W.
