COUNTY SURVEYOR
RECORD 2 1869-1900

17-62

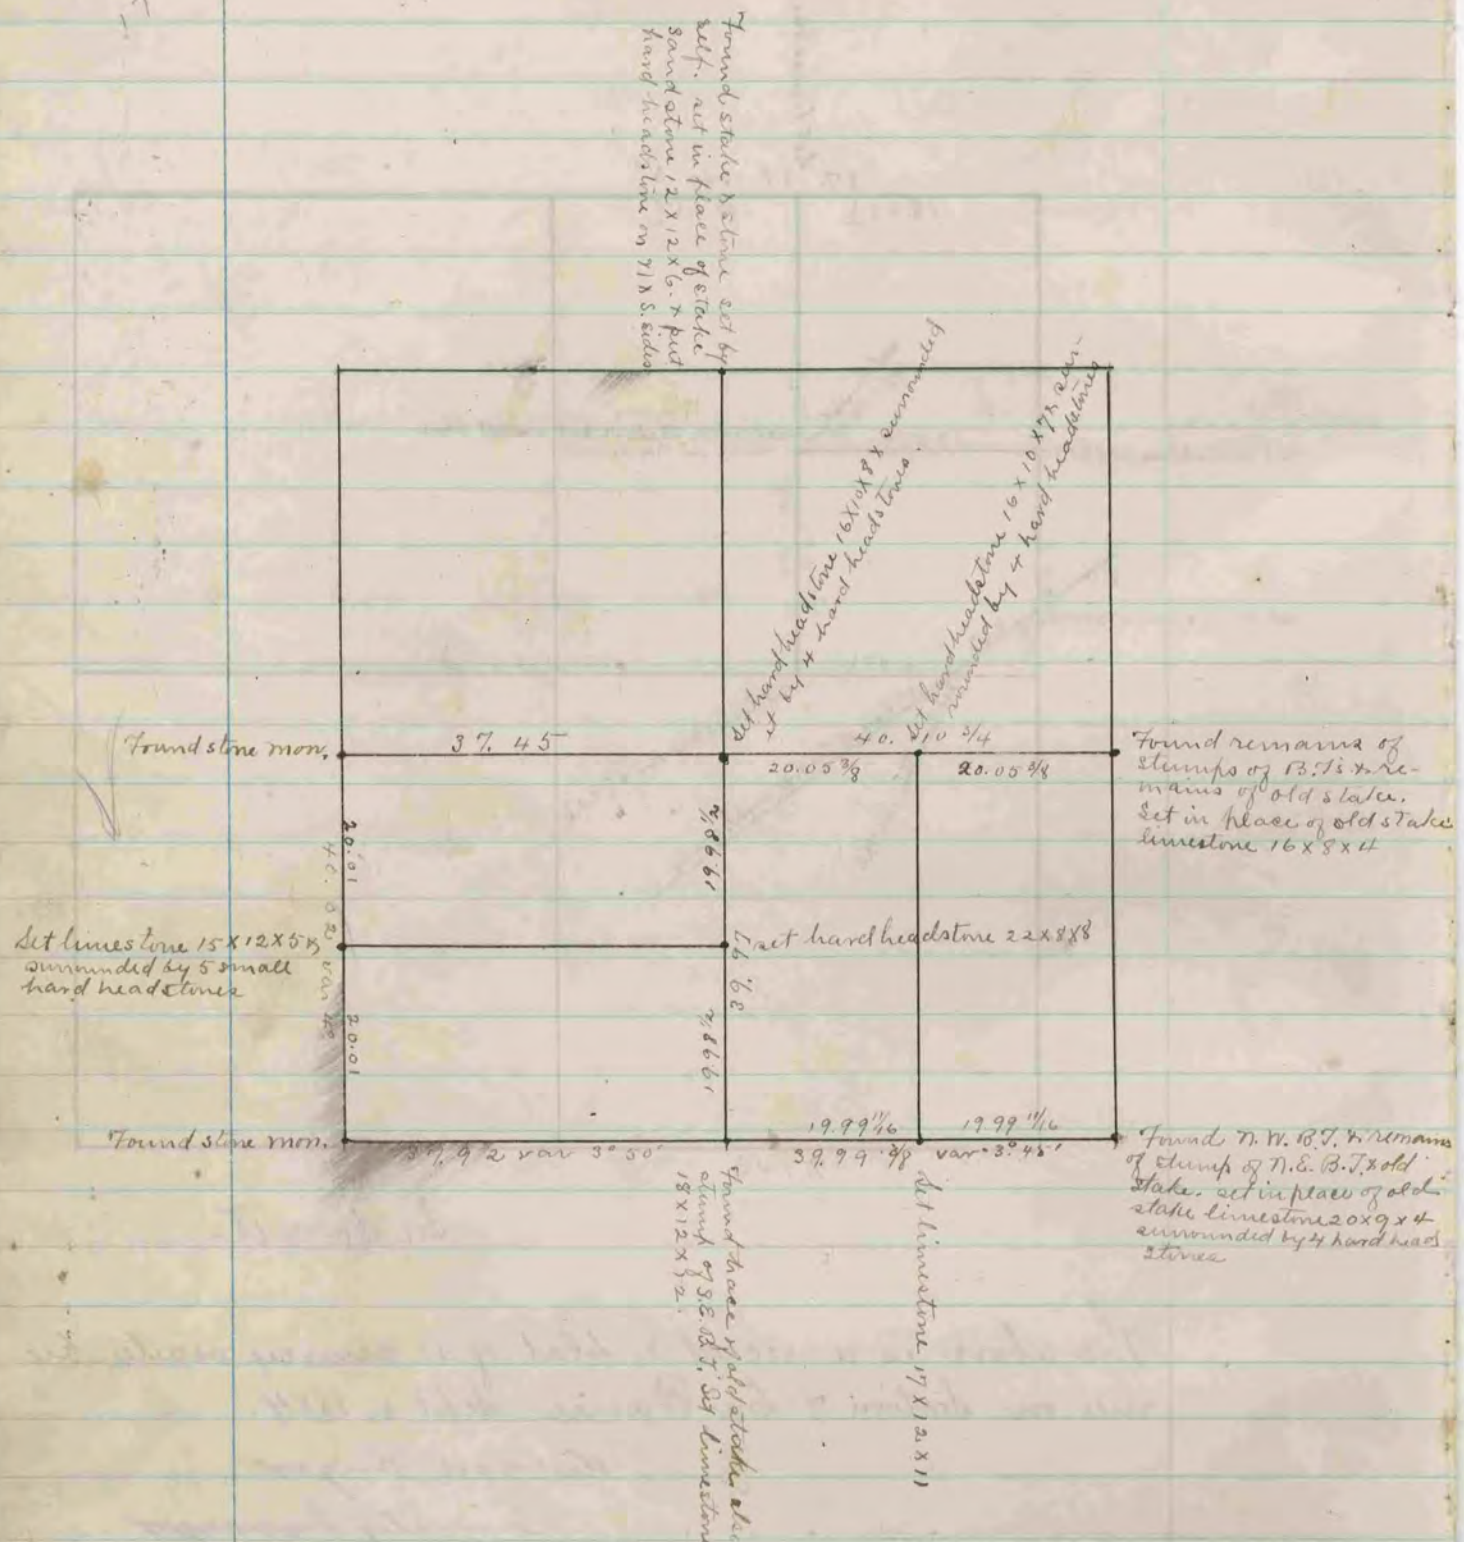

The above is a record & plat of a survey made by me on Section 31 Lima, Sept. 8, 1884.

Edward Ruger
County Surveyor

COUNTY SURVEYOR
RECORD 2 1869-1900