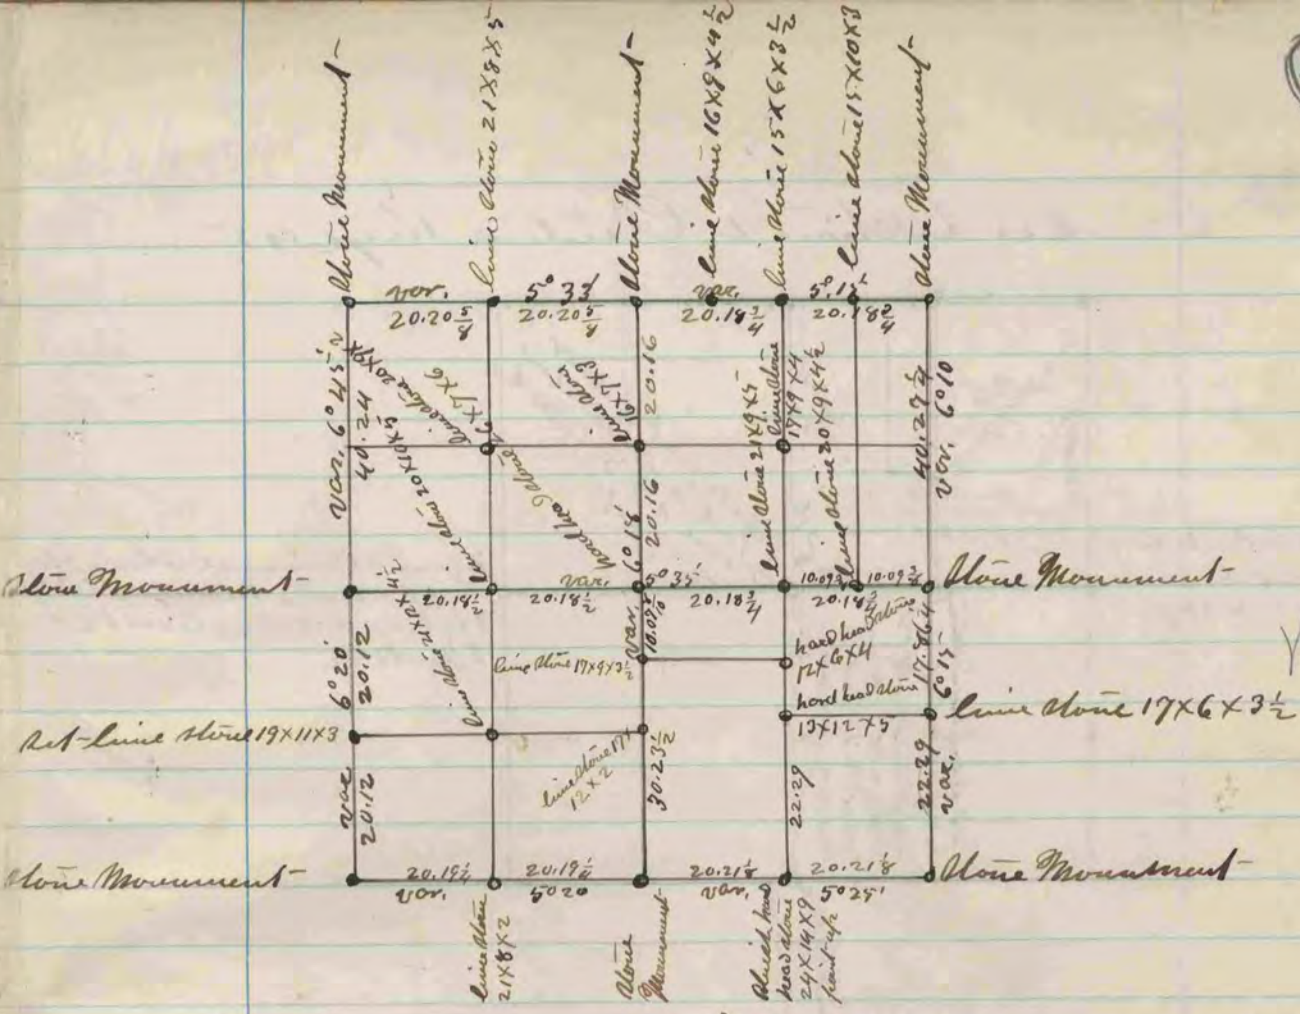

The above is a plat and record of a survey made by me
on section 33 Plymouth – Oct. 8. 10 & 11 - 1871
Edward Ruger
County Surveyor

COUNTY SURVEYOR
RECORD 2 1869-1999

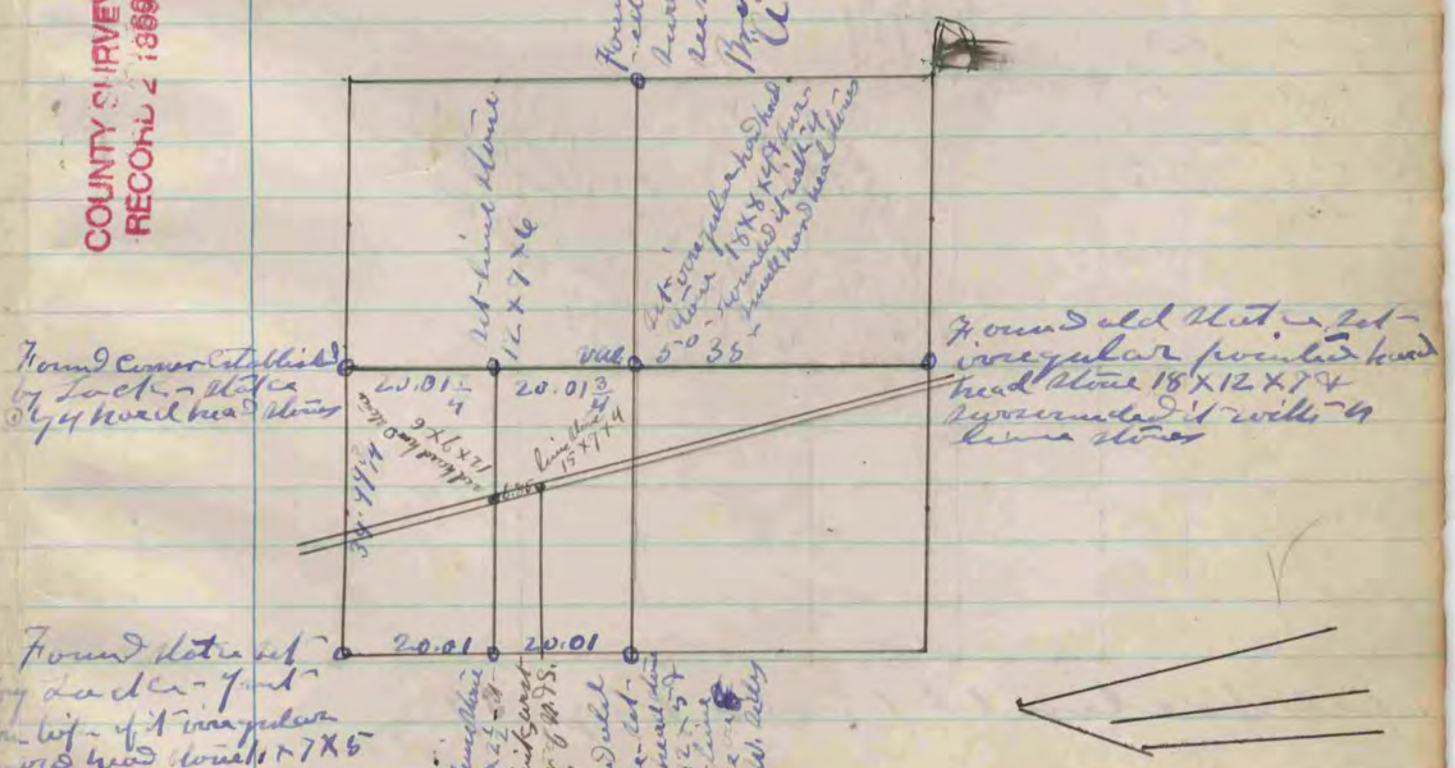

The above is a plat and record of a survey made by me
on section 2 Clinton Oct. 12-1871
Edward Ruger
County Surveyor