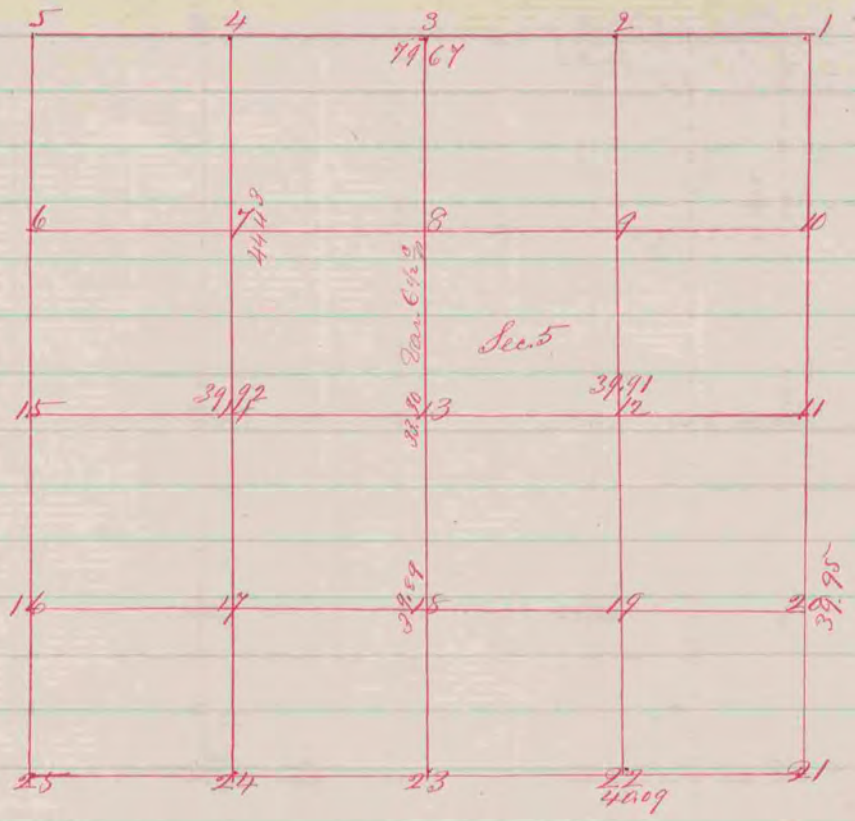

Fig. 13 Represents the centre of the Sec.
" " buried a stone 15 inches long, 10 wide, 5 thick even with the surface of the ground
Fig. 12 buried a stone 18 inches in sod fence

The above is a correct Record Plat of a Survey made by me on Sec. 5. T. 1. R. 13. Turtle May 16. 1859.

Peter McBean Co. Surveyor

Rec Vol 1 Pg 19

COUNTY SURVEYOR
RECORD 1859-1906