COUNTY SURVEYOR
RECORD 1859-1906

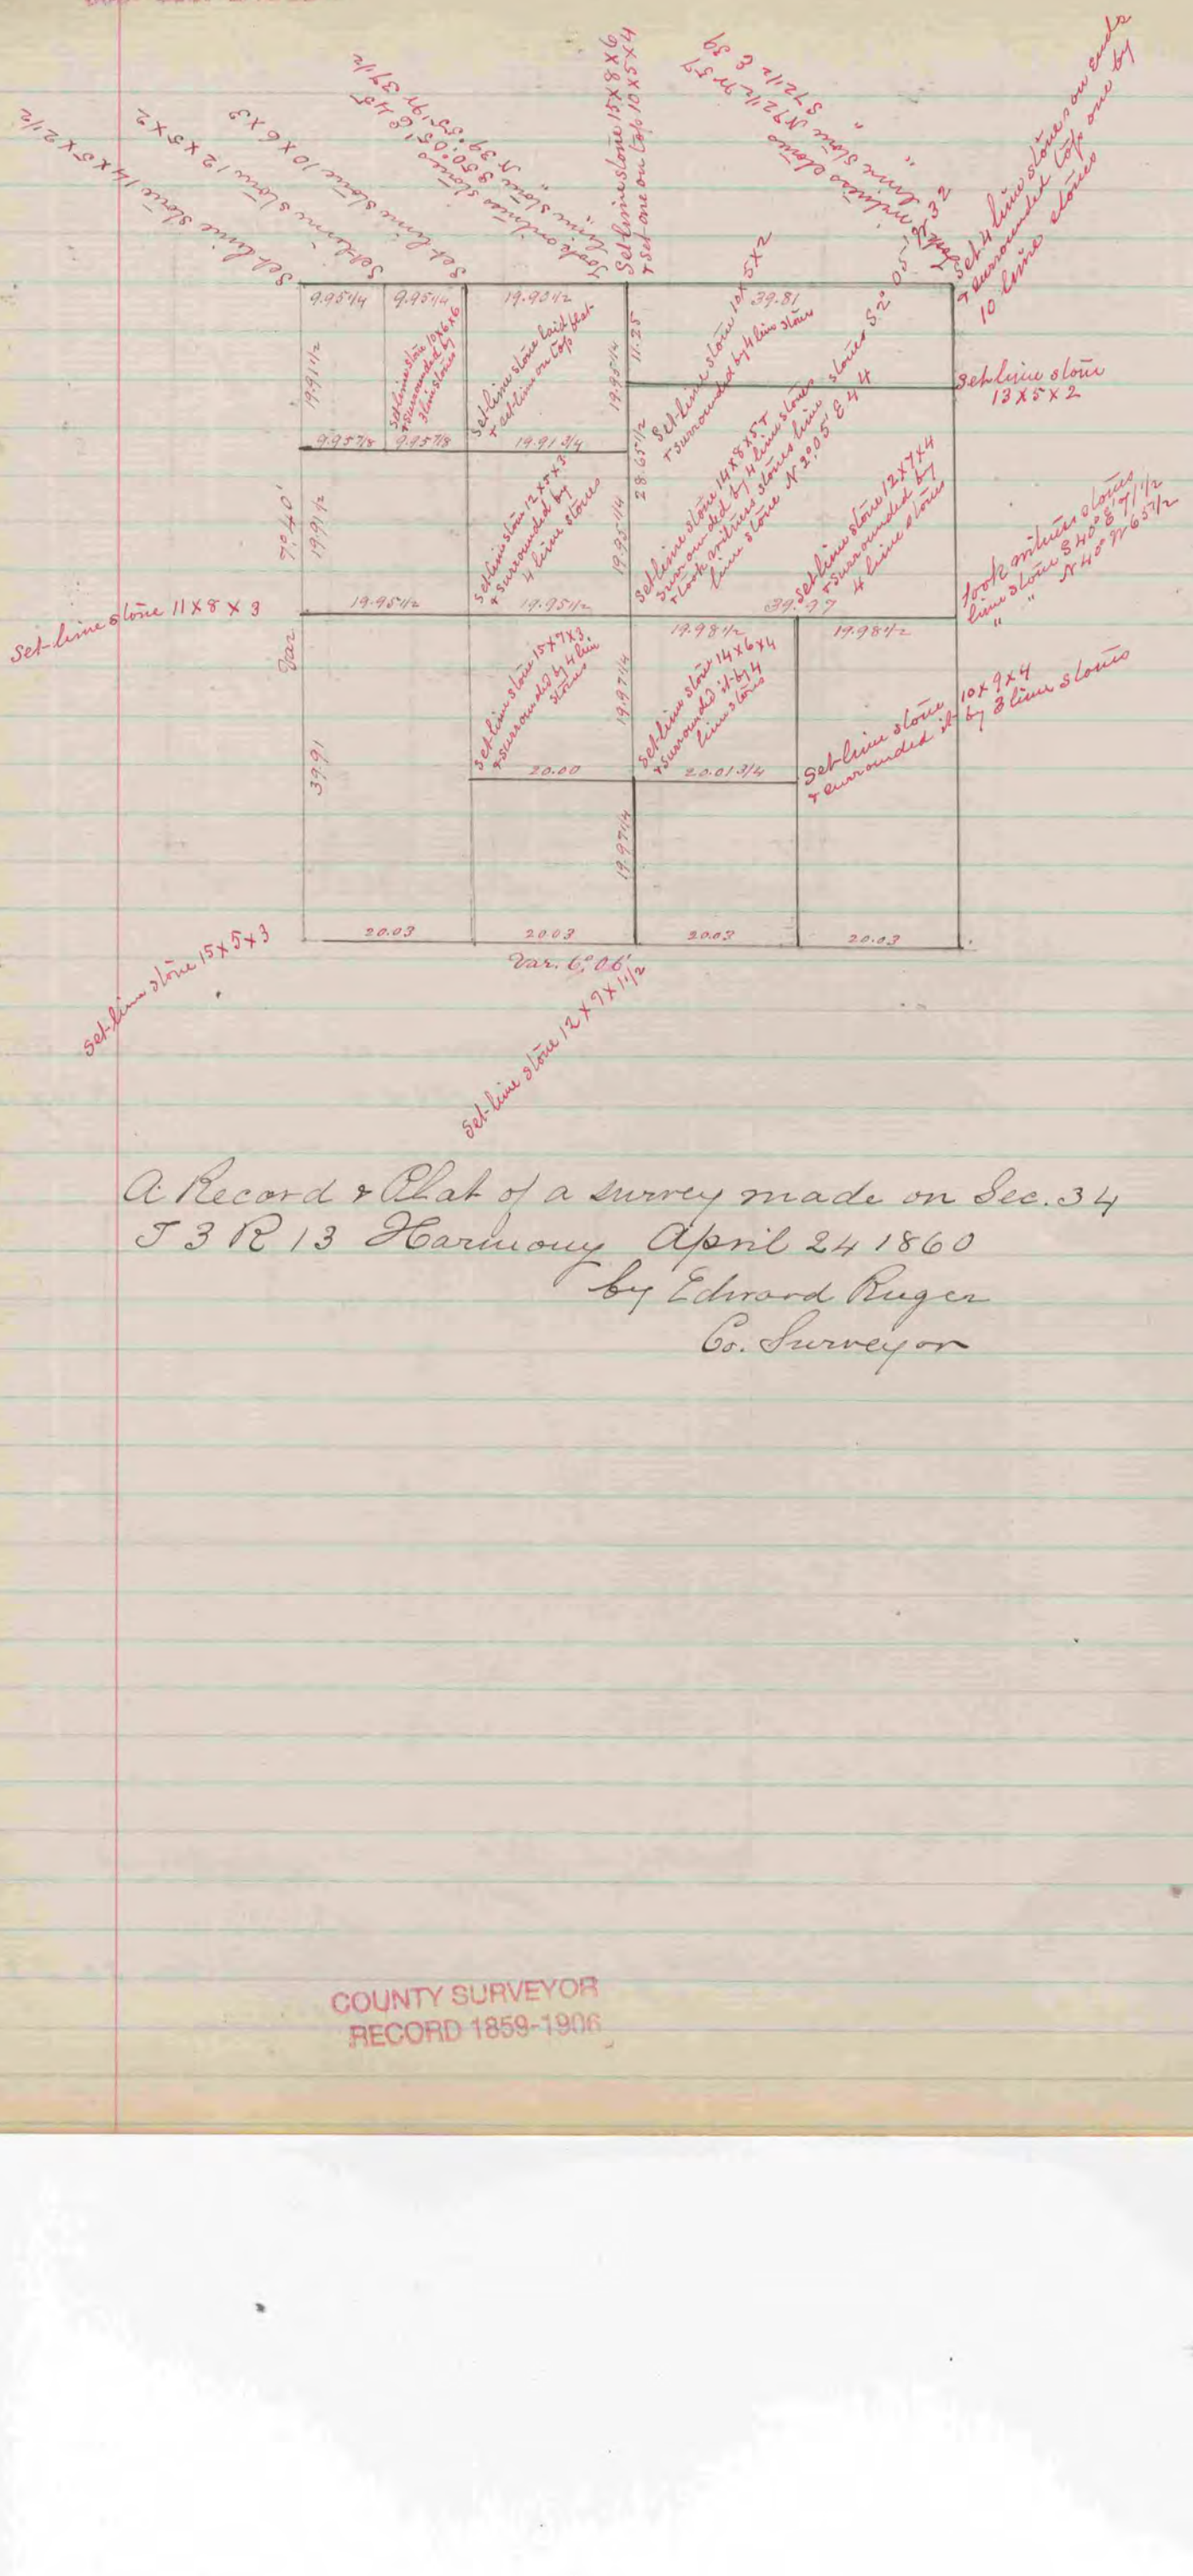

A Record & Plat of a Survey made on Sec. 34
T 3 R 13 Harmony April 24 1860
by Edward Ruger
Co. Surveyor

COUNTY SURVEYOR
RECORD 1859-1906