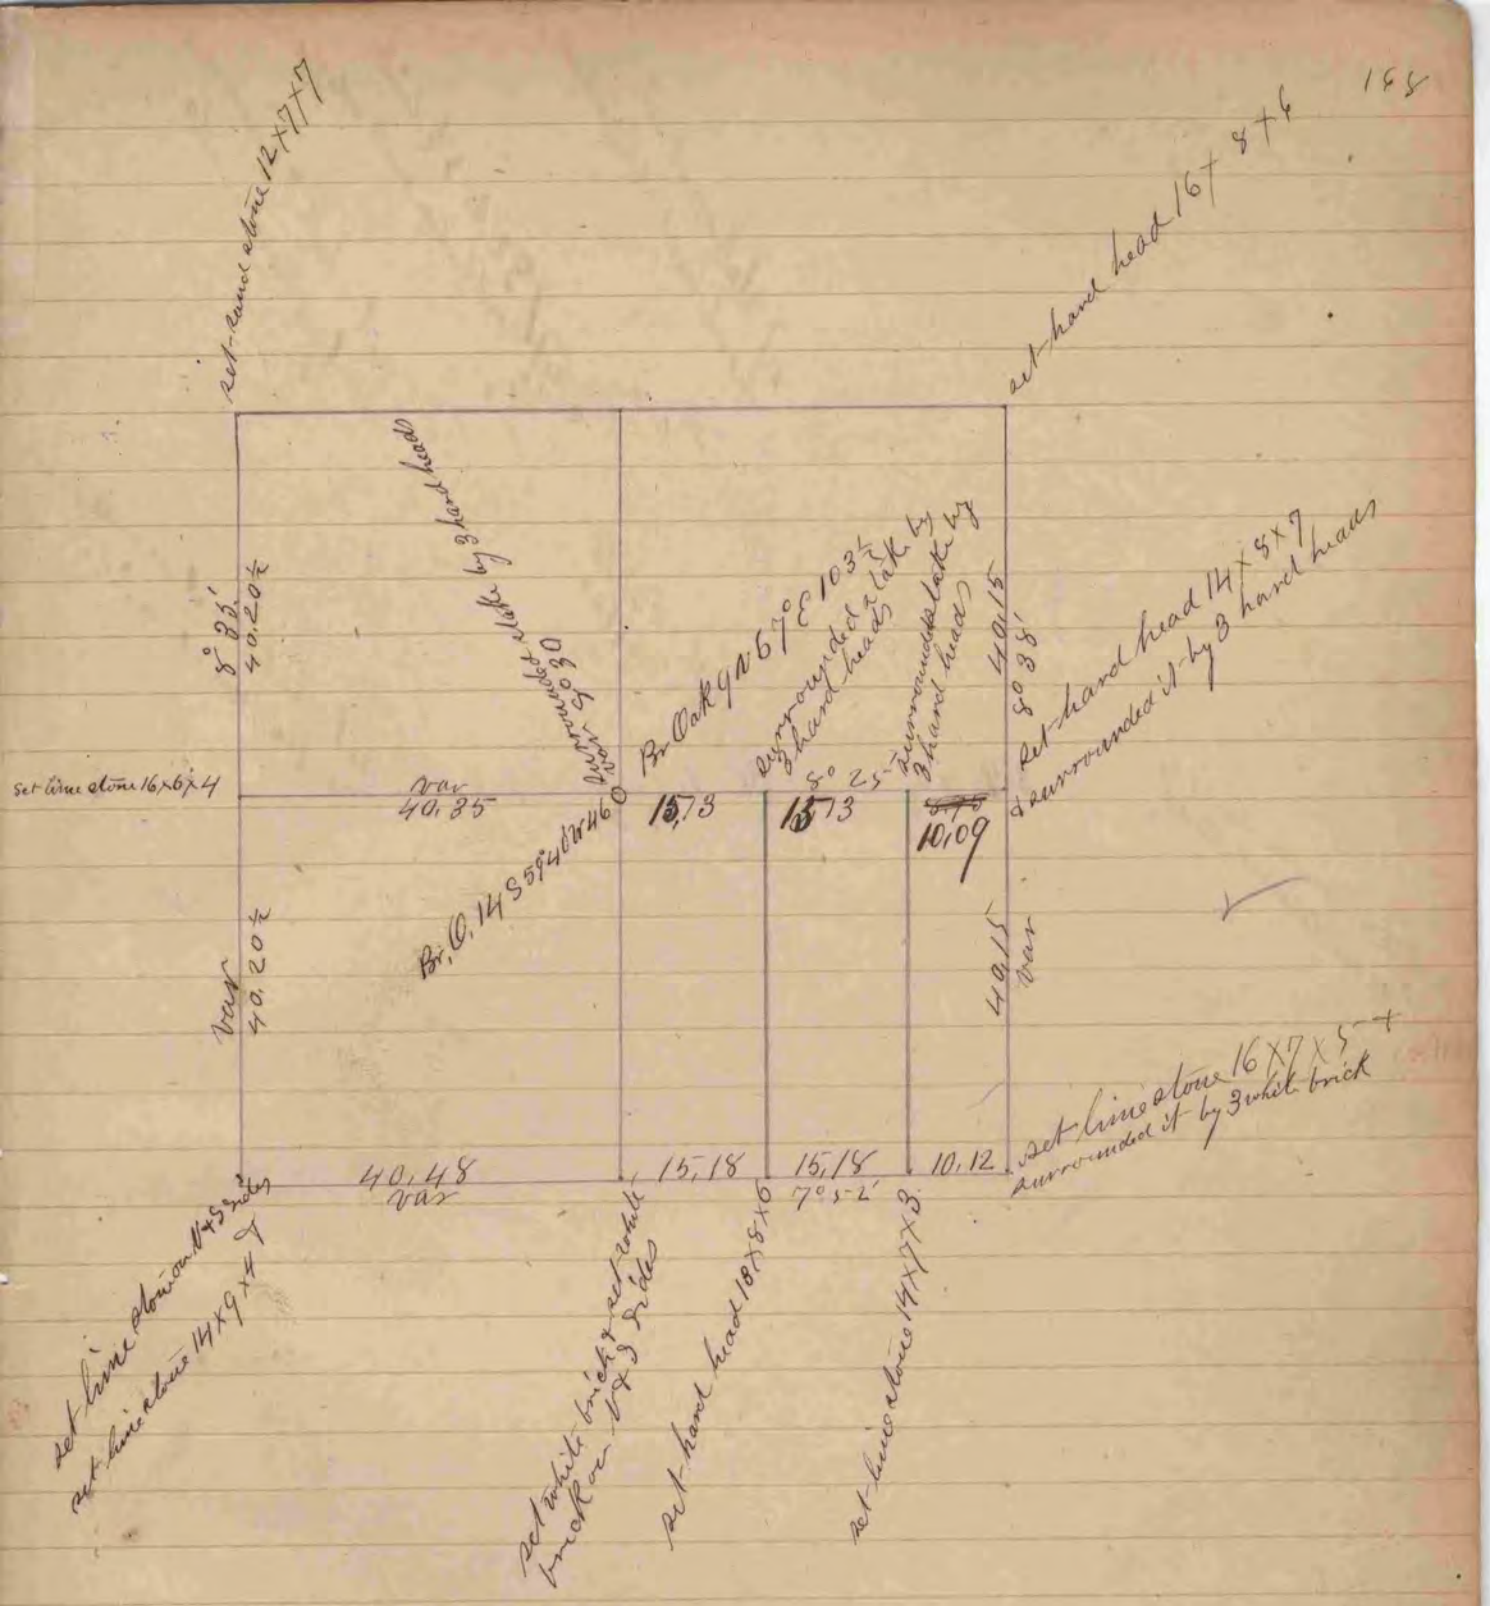

A record and plat of a survey of Madison Section 8 T3 R12 April 19th 1861
Jan 1st by Edward Rugle
County Surveyor for Rock County Wis

COUNTY SURVEYOR
RECORD 1 1851-1869