Turtle
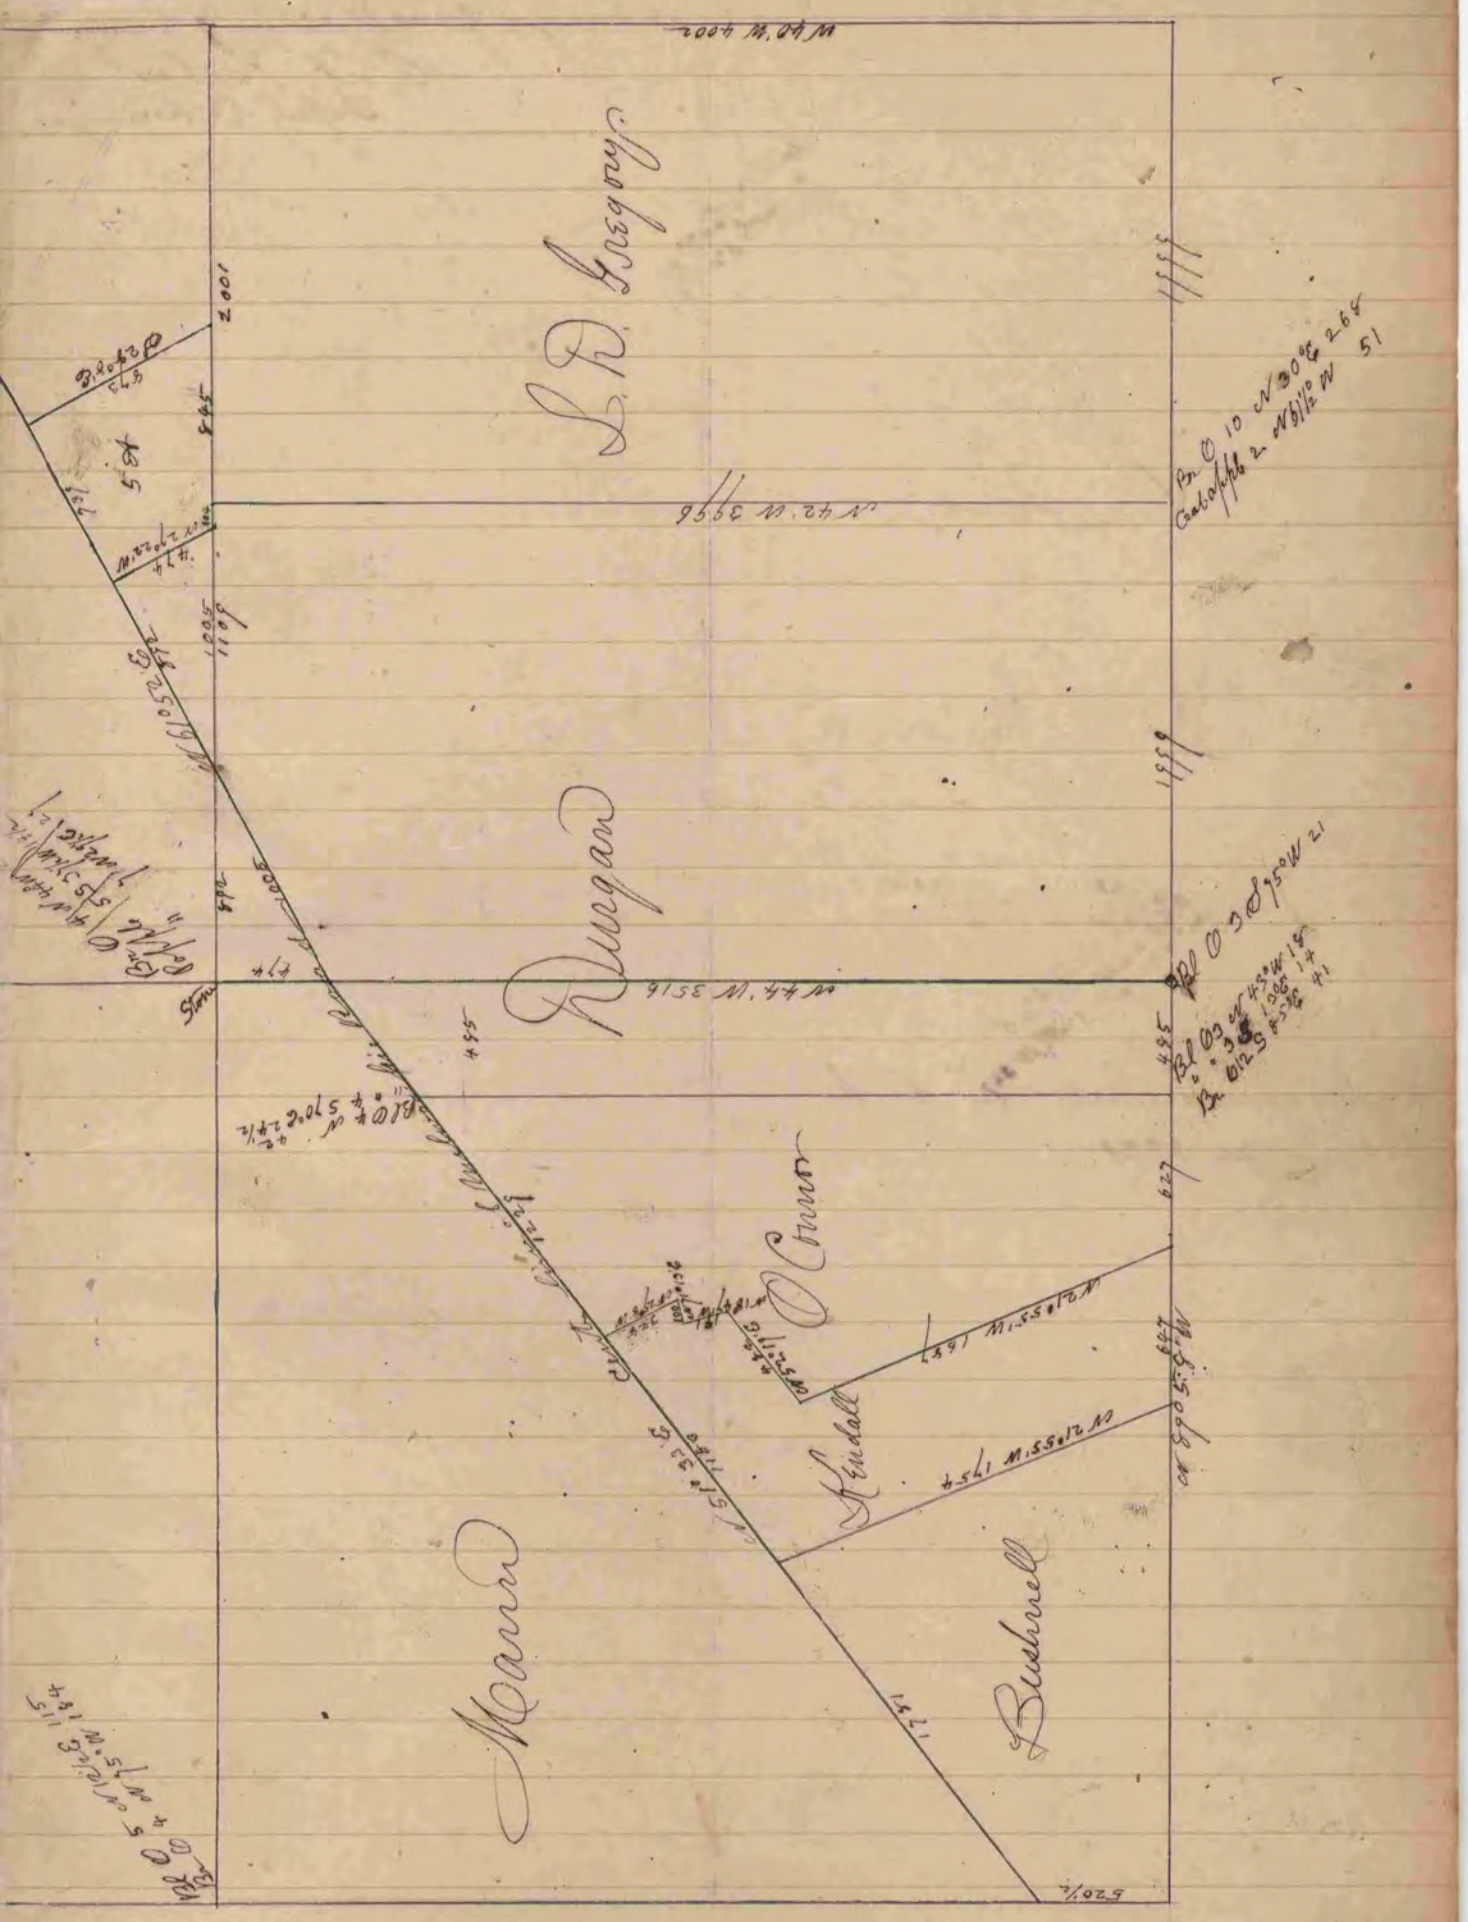
COUNTY SURVEYOR
RECORD 1 1851-1869