COUNTY SURVEYOR
RECORD 1 1851-1869

A Record and Plat of a Survey made on Sec
Thirty Four Town Two North Range Twelve East

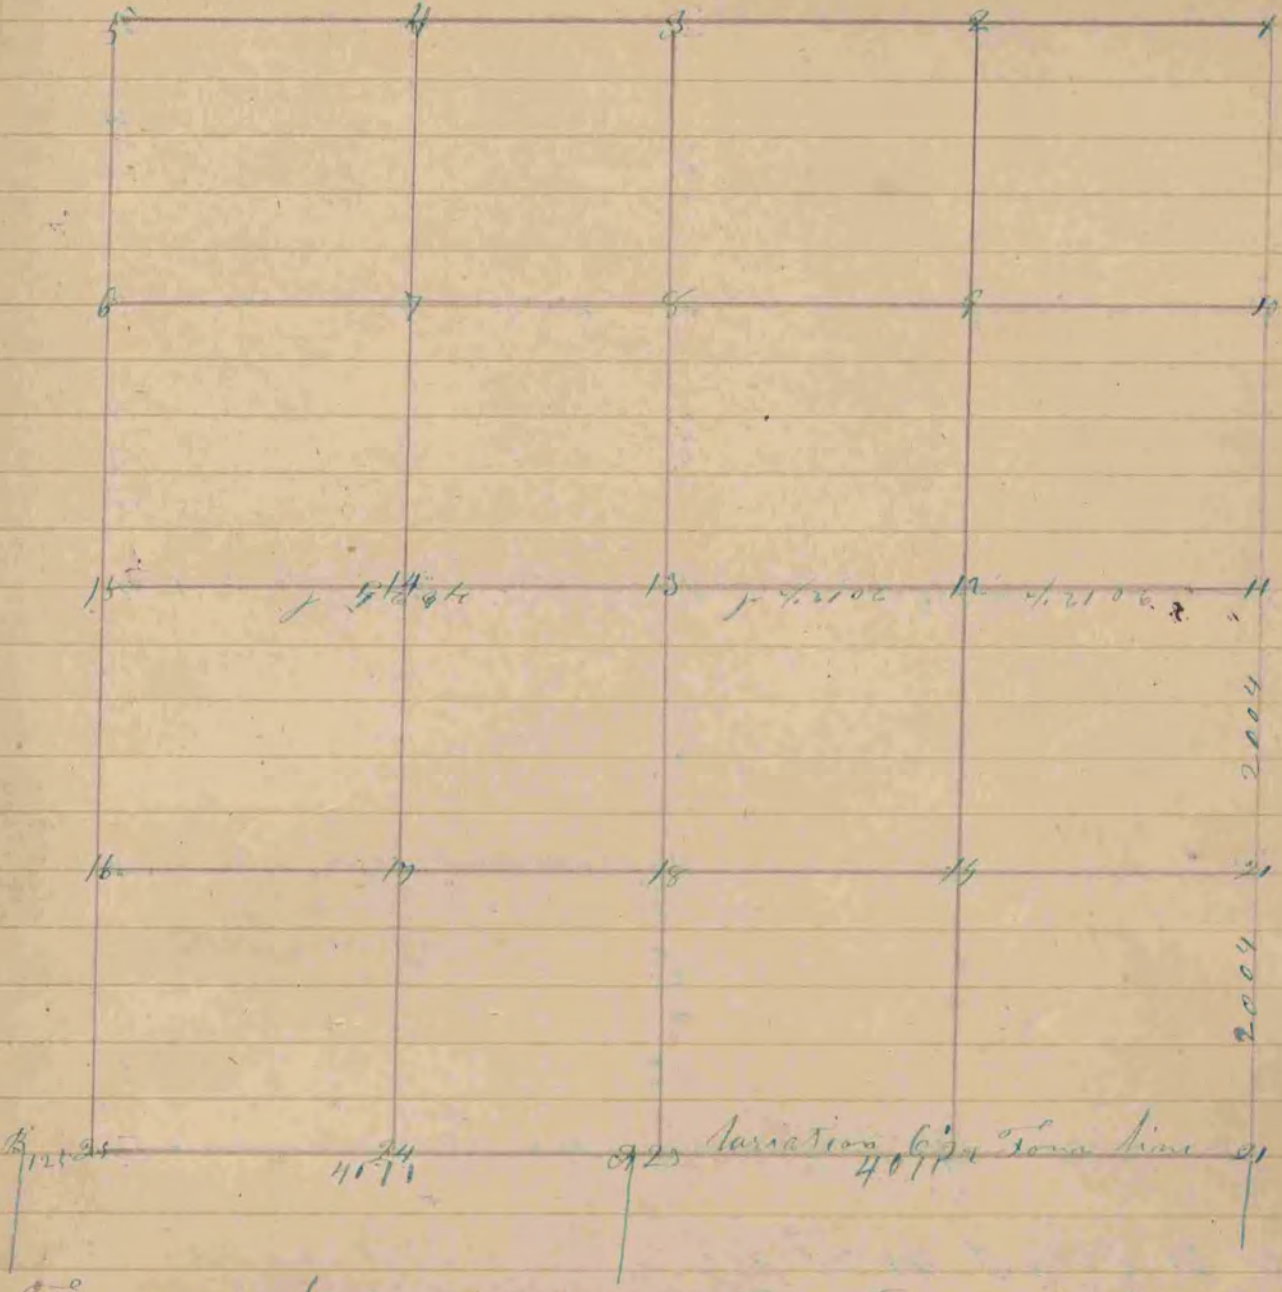

Fig 13 Stake Marked on The Prairie no Bearings
18 " " " " in the Centre of Highway
Set A on the South line in the Centre Between
" B & Fig 21 one Stake Marked no Bearing

The Above Survey was made on the
11th day of June 1858 Rock
Joseph Church County
Surveyor of Rock
County Wis