COUNTY SURVEYOR
RECORD 1859-1906

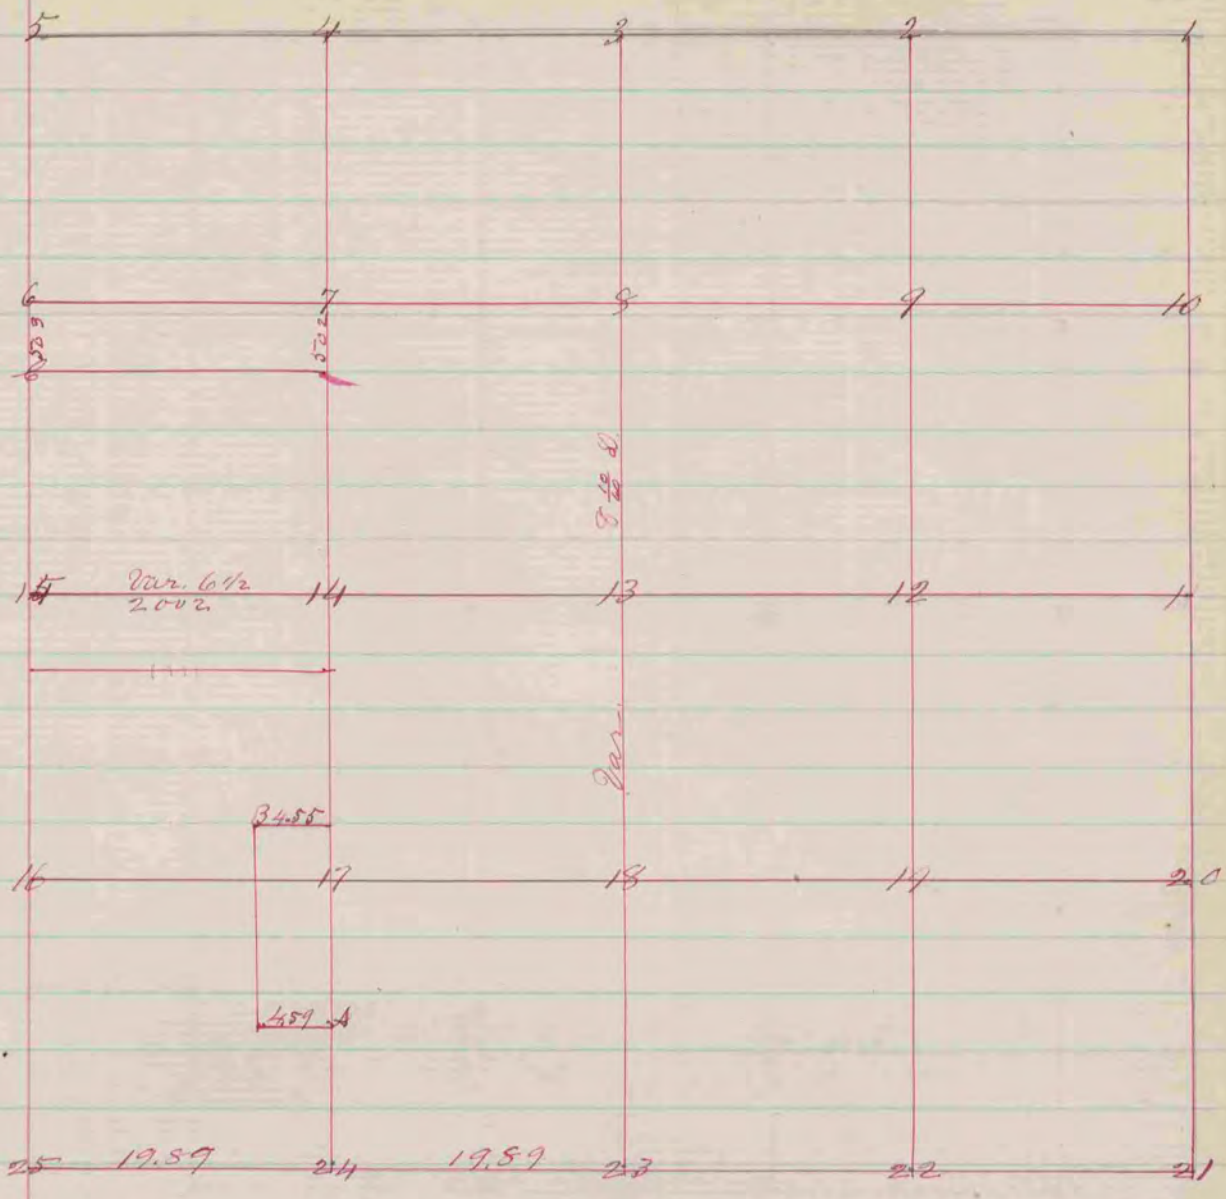

Fig. 24 Br. C. 15 N 15 W 75
Letter A " " 14 S 88 W 34
16 N 57½ W 45
" B " " 15 N 73 W 120
" " 14 N 36 E 98
6 " 12 N 73 W 57

A Record Plat of a Survey made on Sec. 10. T. 2
R. 7. E. on Feb. 12 1856 Spring Valley
Joseph Church
Co. Surveyor