COUNTY SURVEYOR
RECORD 1 1851-1869

107

A Record and Plat of a survey made on Sec 22 Town 3 Range 12 for T. Wolcott & J. Church

Distances given in chains
Variations mark'd on lines

Surveyed March 24th 1859 by Edward Rega County Surveyor of Rock County Wis

Janesville

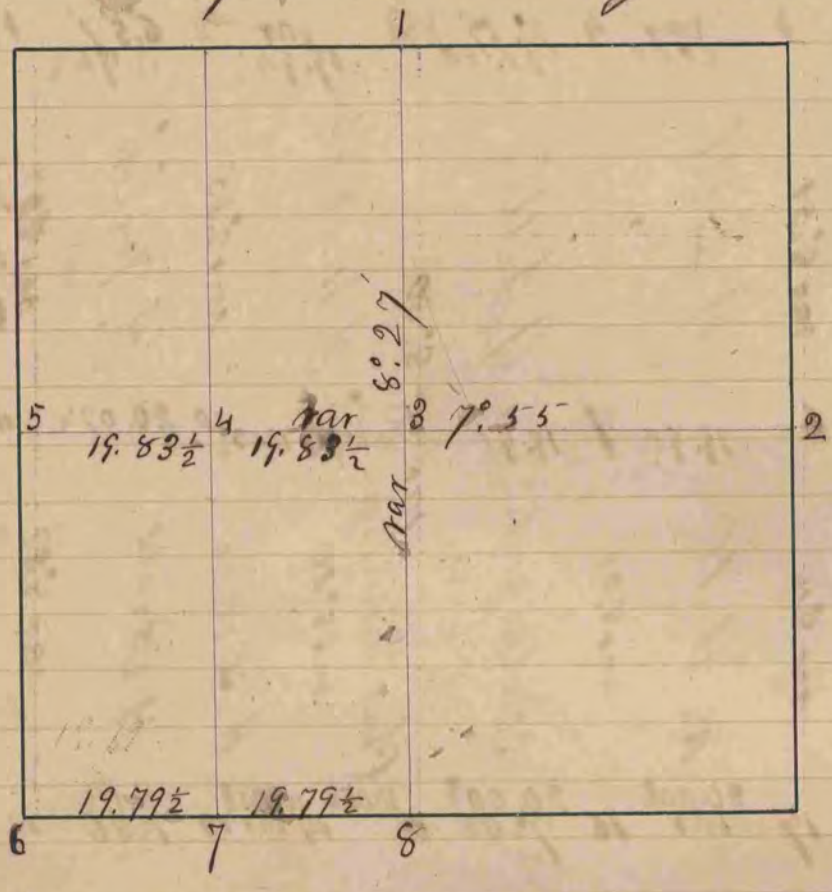

At Fig 1 One old witness Tree standing B.O. 12 N 86 E 34
" " " " " " " Cut down W. O. Stump 12 N 32 W 121
" " 2 Surrounded post by 4 hard heads
" " 3 W.O. 18 N 17° 45 E 5 Ju. 6 24 N 45° 05 E 95½ var 7° 55'
" " " B.O. 5 S 16.25 W 110 W.O. 20 S 45° 28 W 188 "
" " 4 W.O. 14 S 44° W 50 W.O. 12 N 74° 55 E 26 r "
" " 5 Same as Fig 11 Sec 21 of Same Town & Range
" " 6 Same as " 12 " " " " " " "
" " Took no bearings
" " 8 Old W. Tr. Standing W.O. 18 N 15 E 15 W.O. 19 S 5 W 24
" " but being Highway took new ones
" " W.O. 17 S 60. 20 W 78⅓ W.O. 20 N 71° 10 W 90½ var 8° 35'