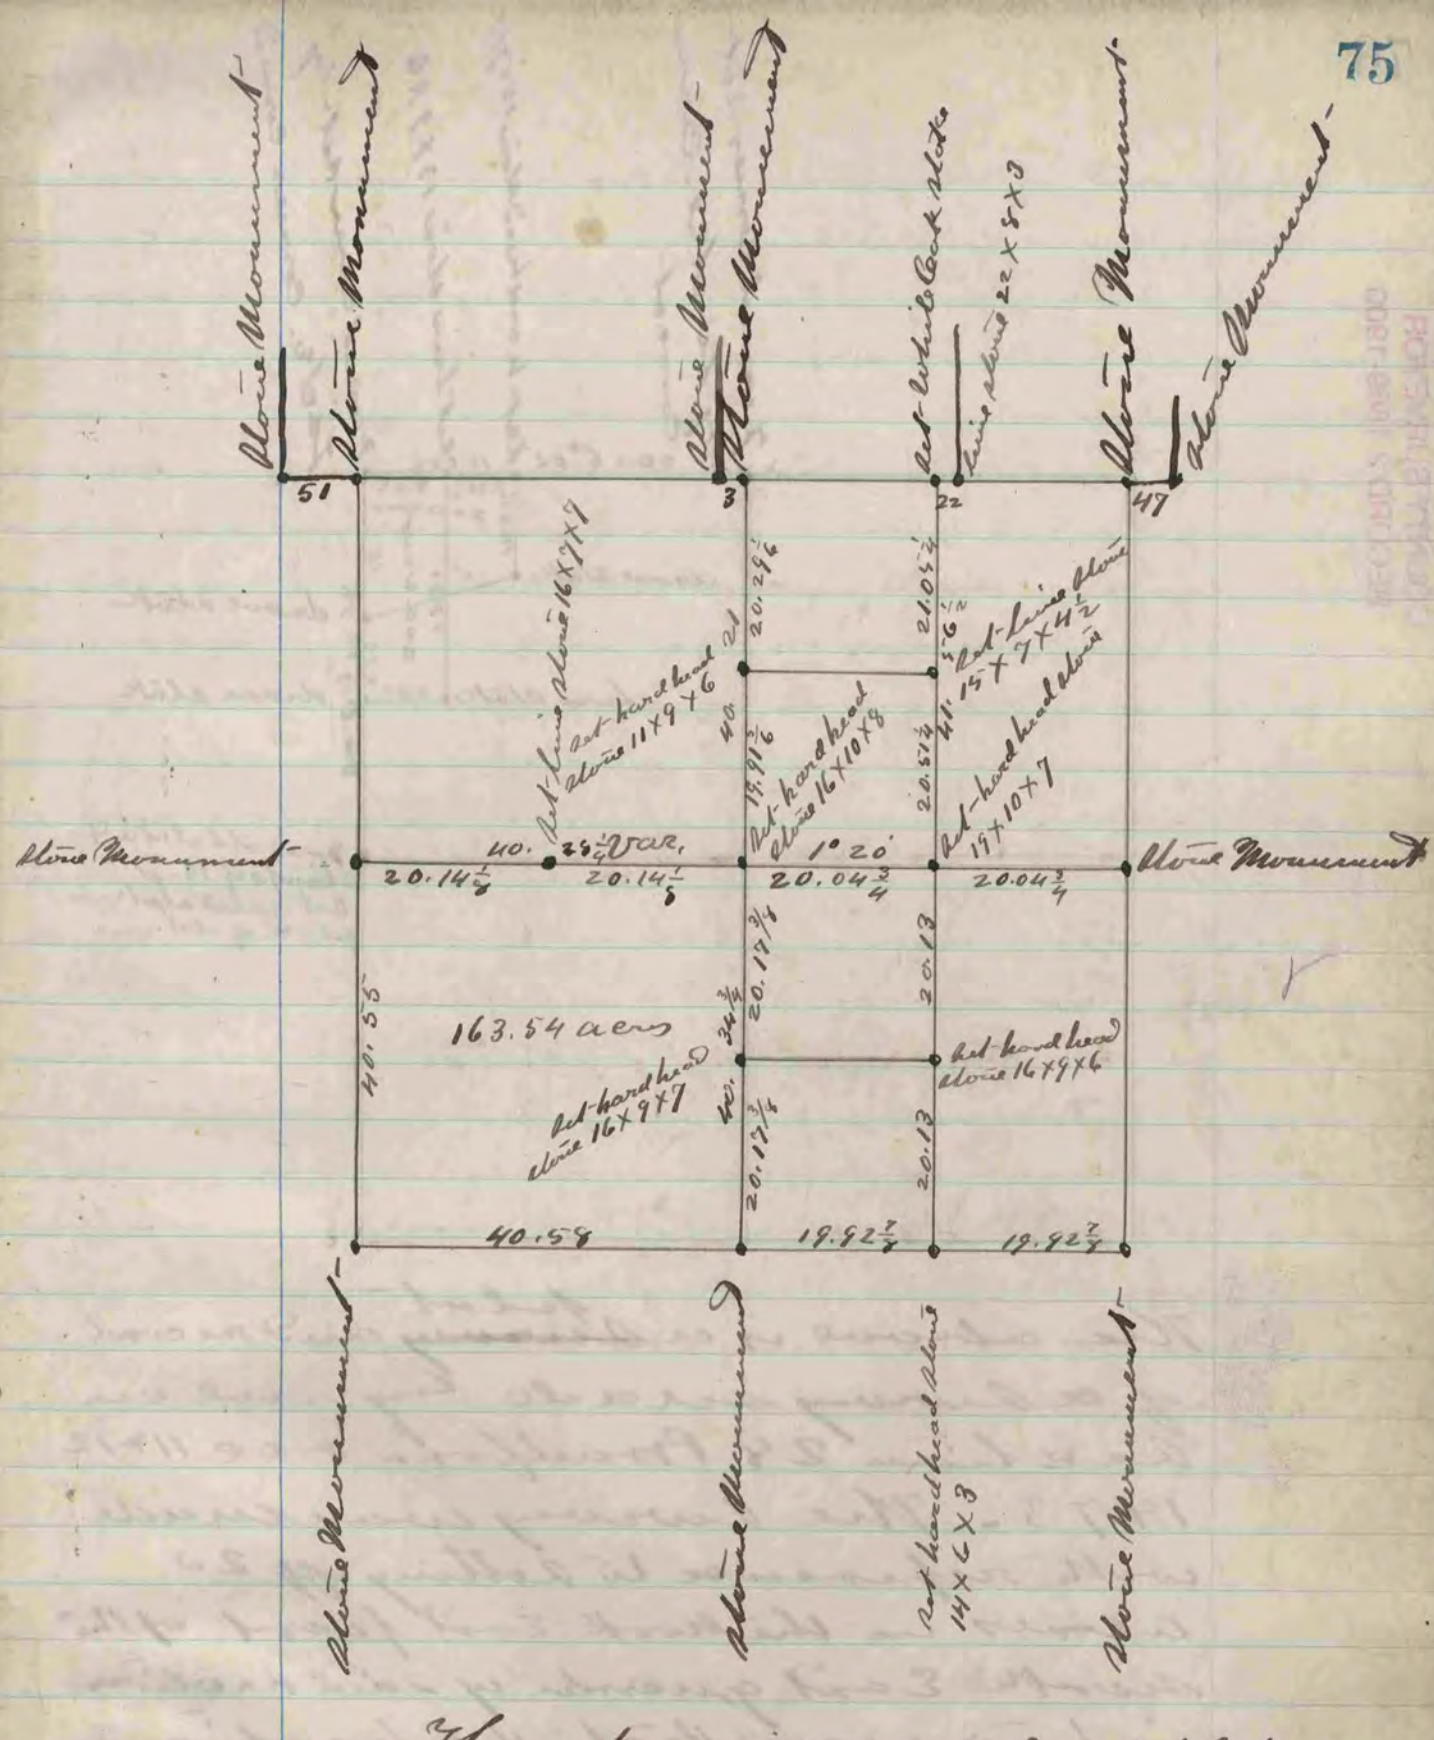

The above is a record and plot of a survey made by me on Sec. 7 Newark Dec. 4 + 5 - 1873

Edward Rogers
County Surveyor

COUNTY SURVEYOR
RECORD 2 1869-1900