198

COUNTY SURVEYOR
RECORD 2 1869-1900

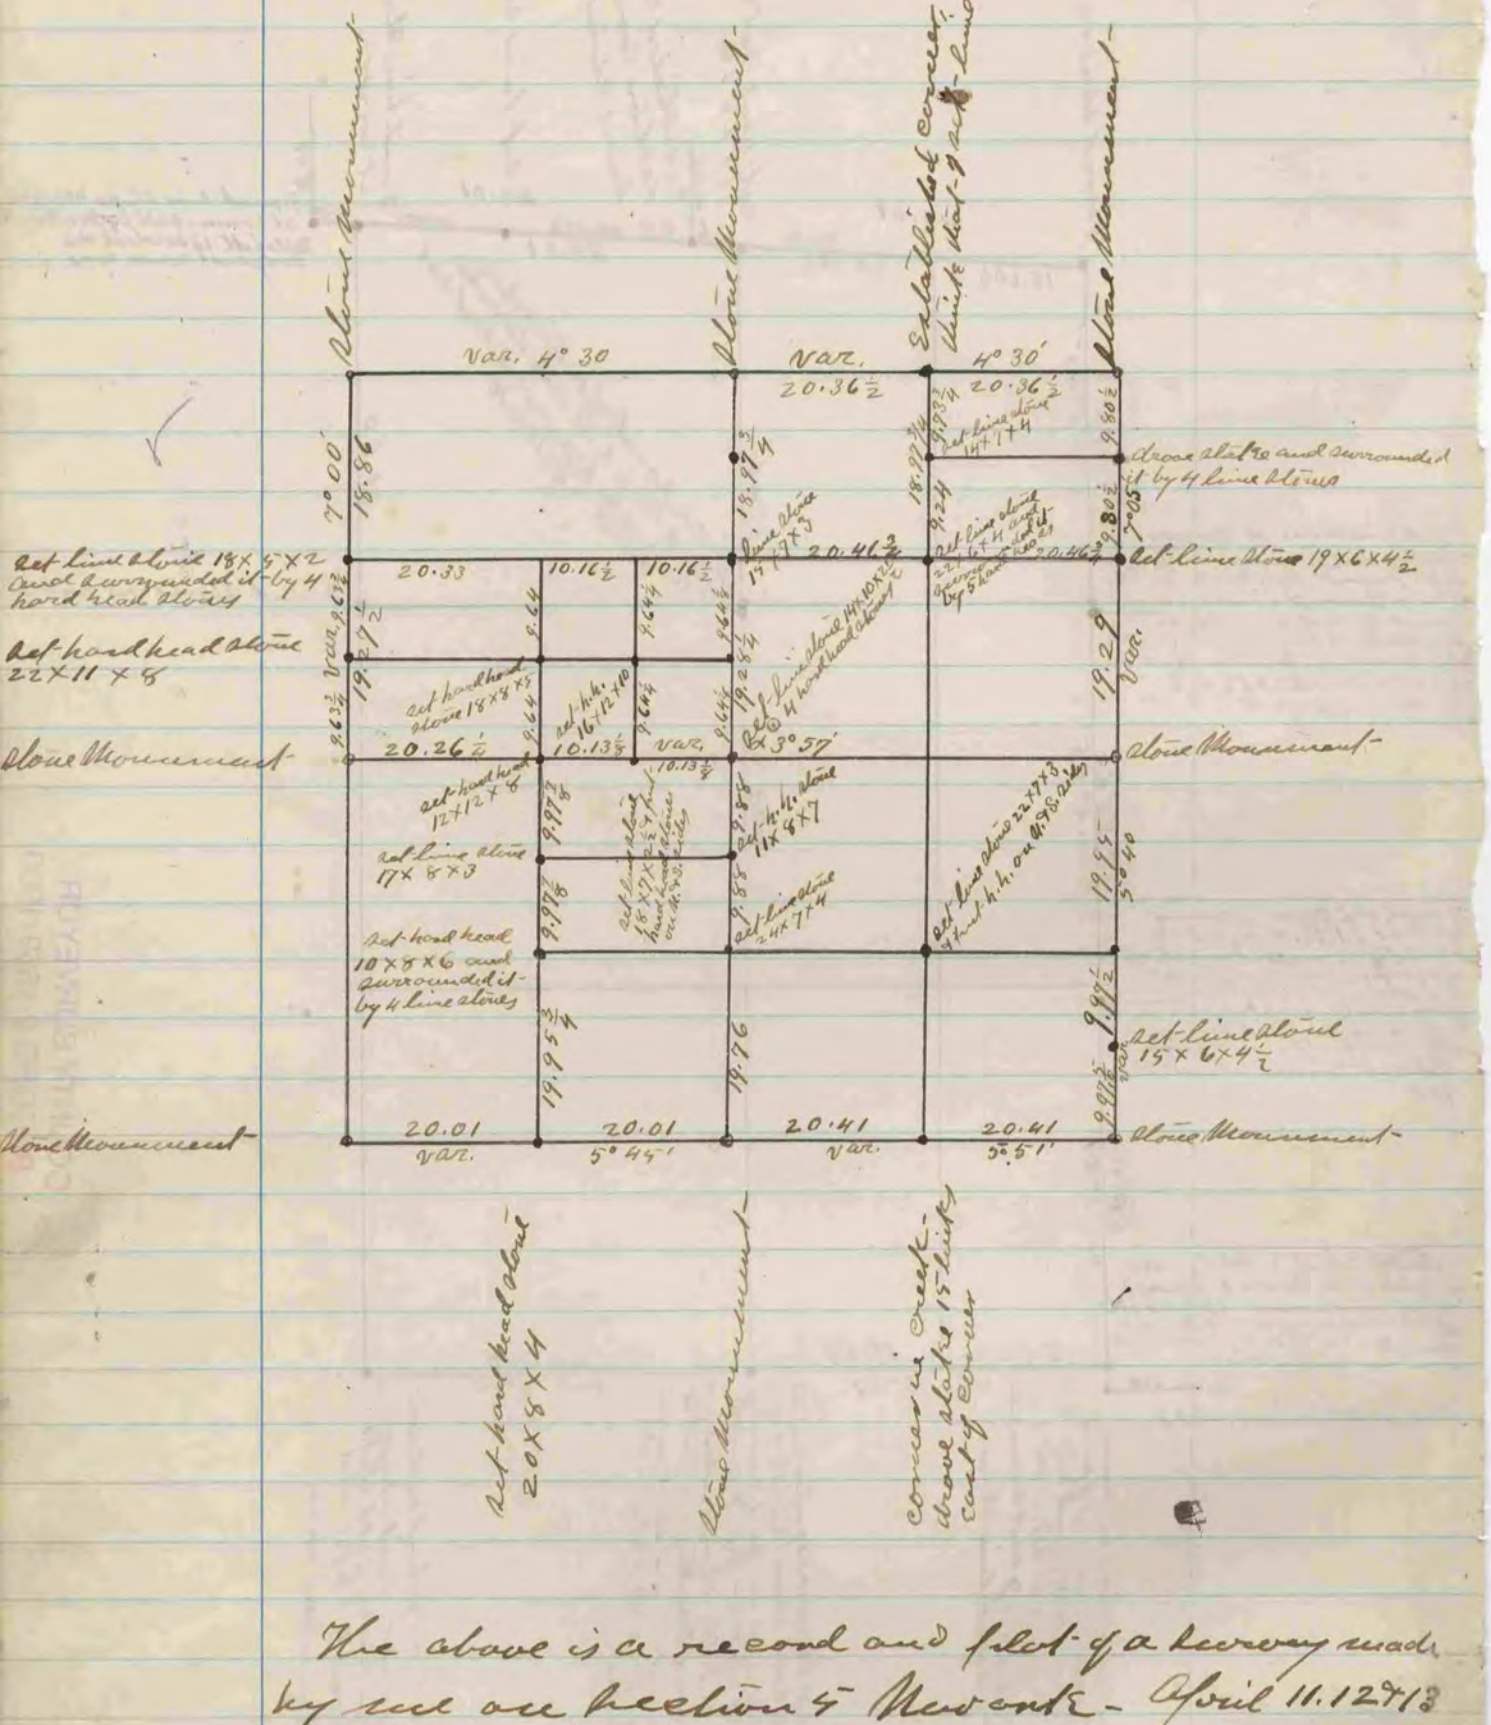
Var. 4° 30
Var.
4° 30'
20.36½
20.36½
Stone Monument
Stone Monument
Stone Monument