COUNTY SURVEYOR
RECORD 2 1869-1900

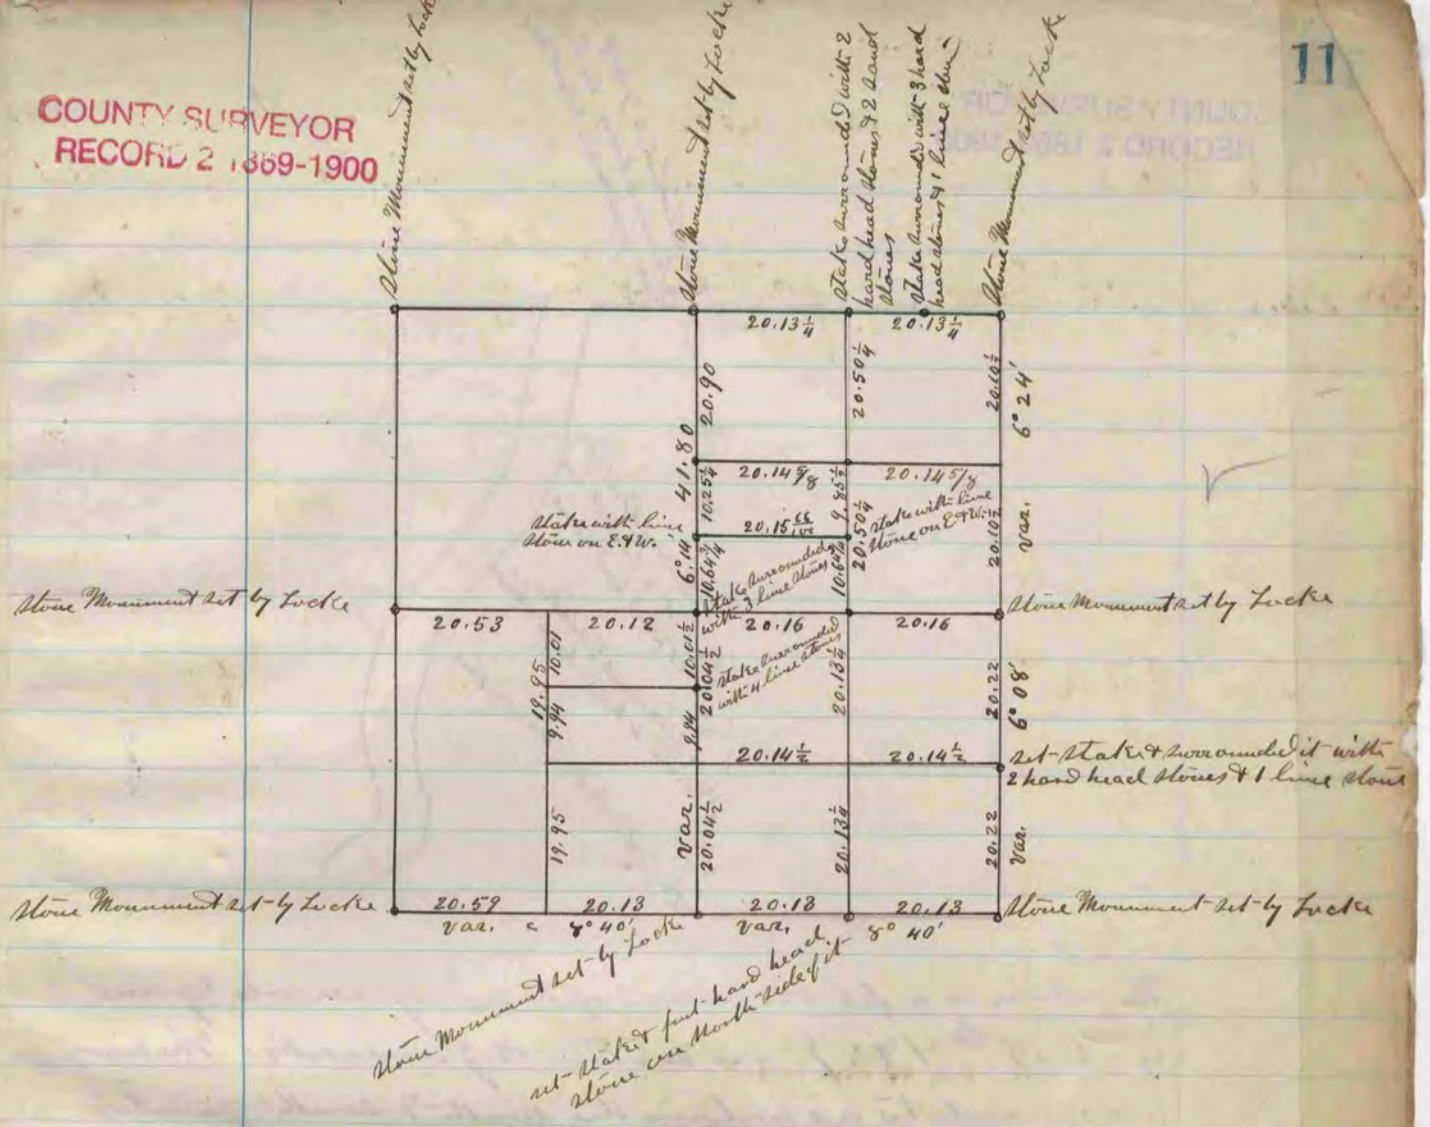

This above is a plat & record of a survey of Section 7 Plymouth made by me Sept. 28th & 29th 1869

Edward Ruger
Dep't. Co. Surveyor

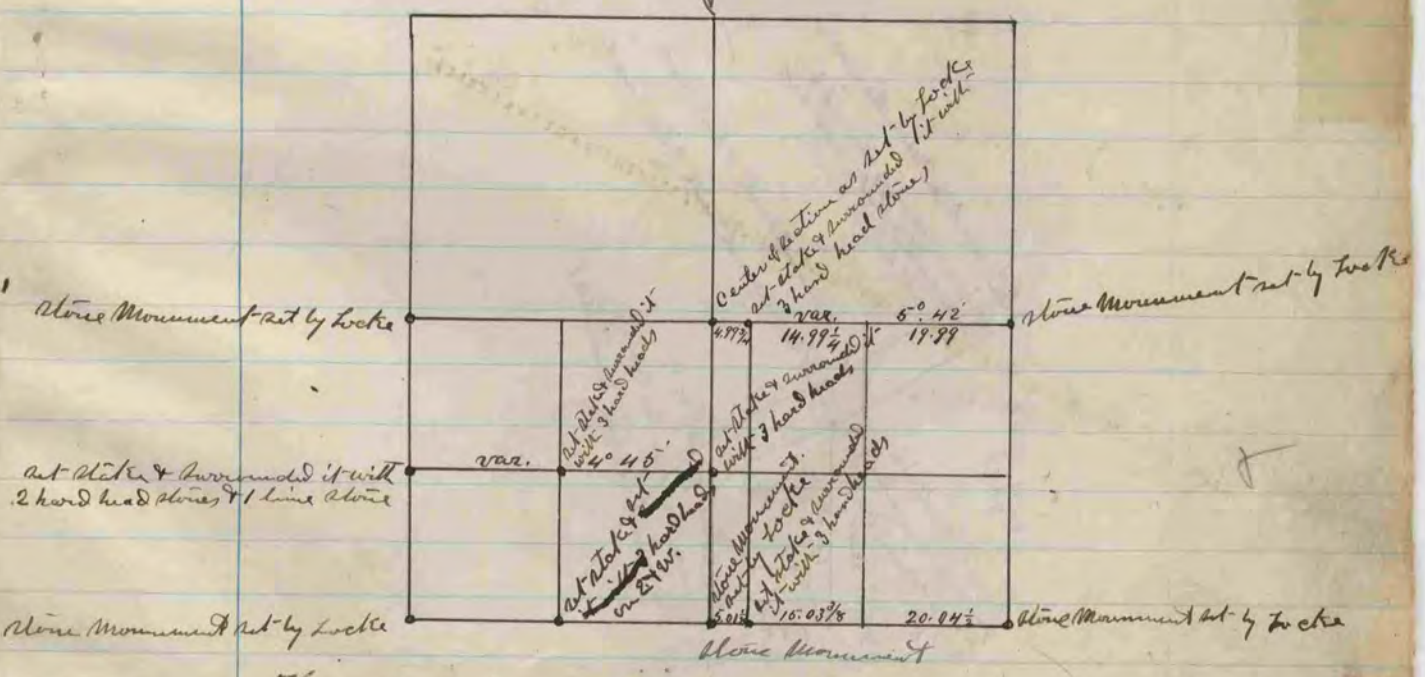

The above is a plat & record of a survey made by me Sept 30th 1869 on Section 8 Plymouth

Edward Ruger
Dep't. Co. Surveyor