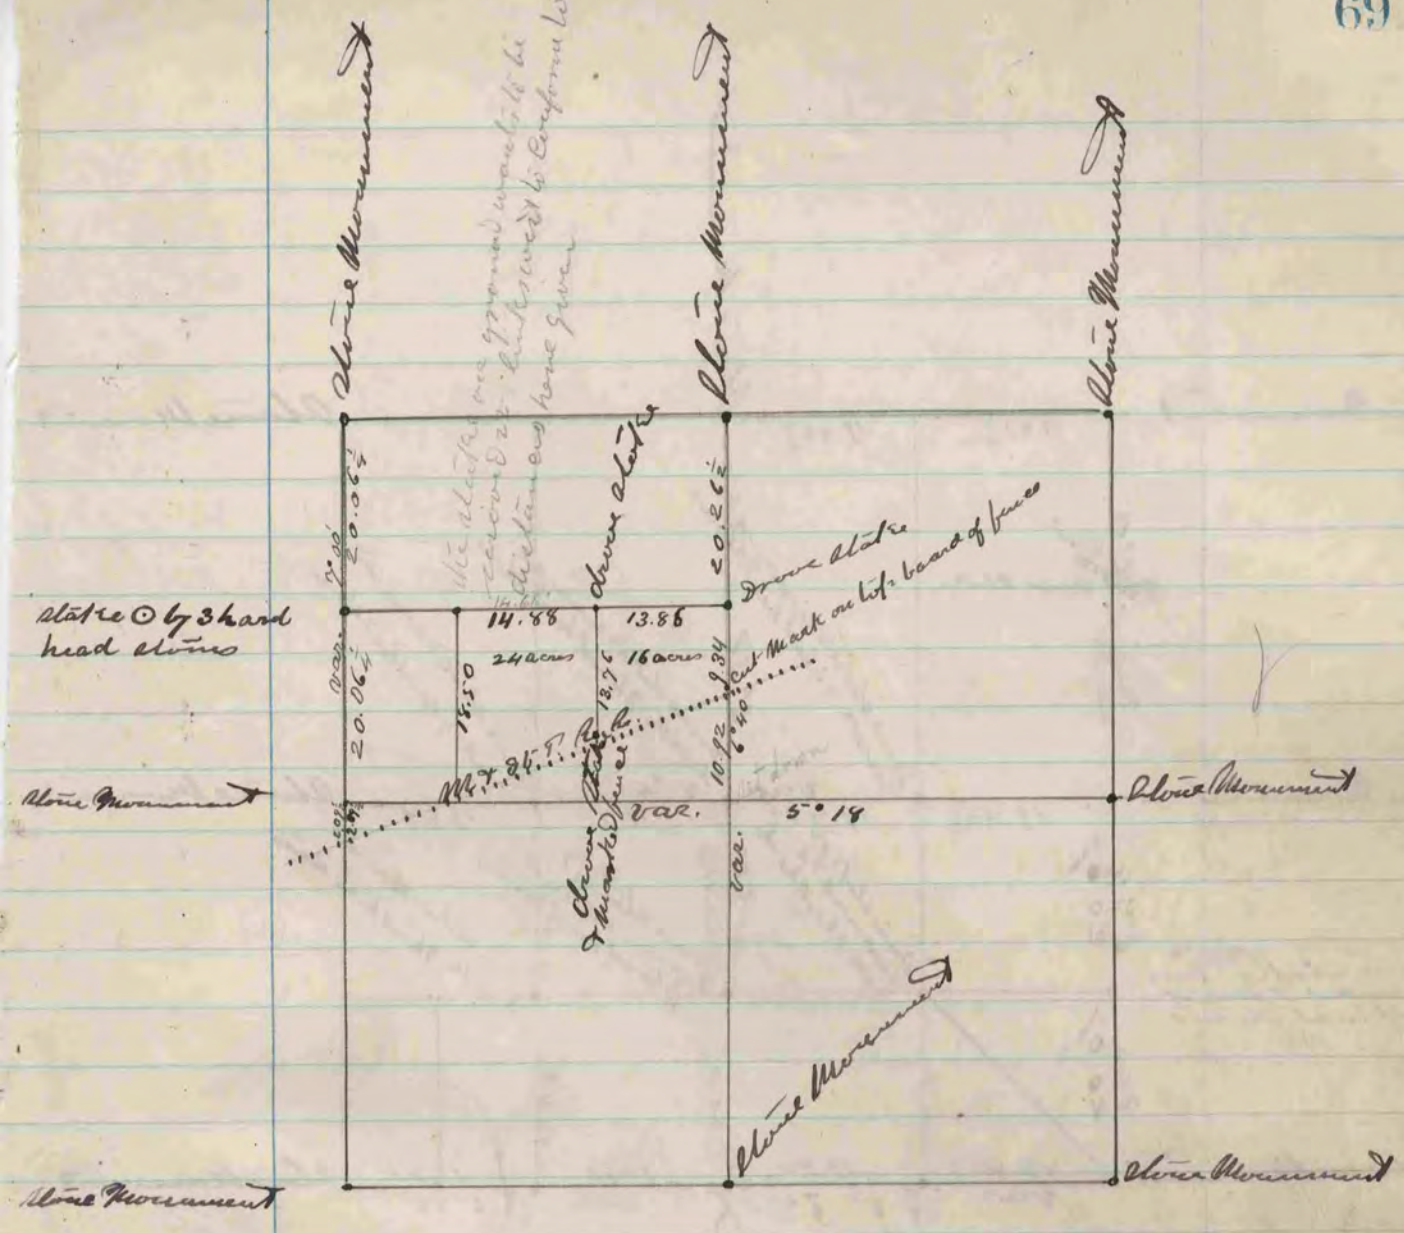

The above is a record and plat of a survey made by me on section 16 T Plymouth - Oct. 20 - 1873

Edward Reeger
County Surveyor

COUNTY SURVEYOR
RECORD 2 1869-1900