COUNTY SURVEYOR
RECORD 2 1869-1900

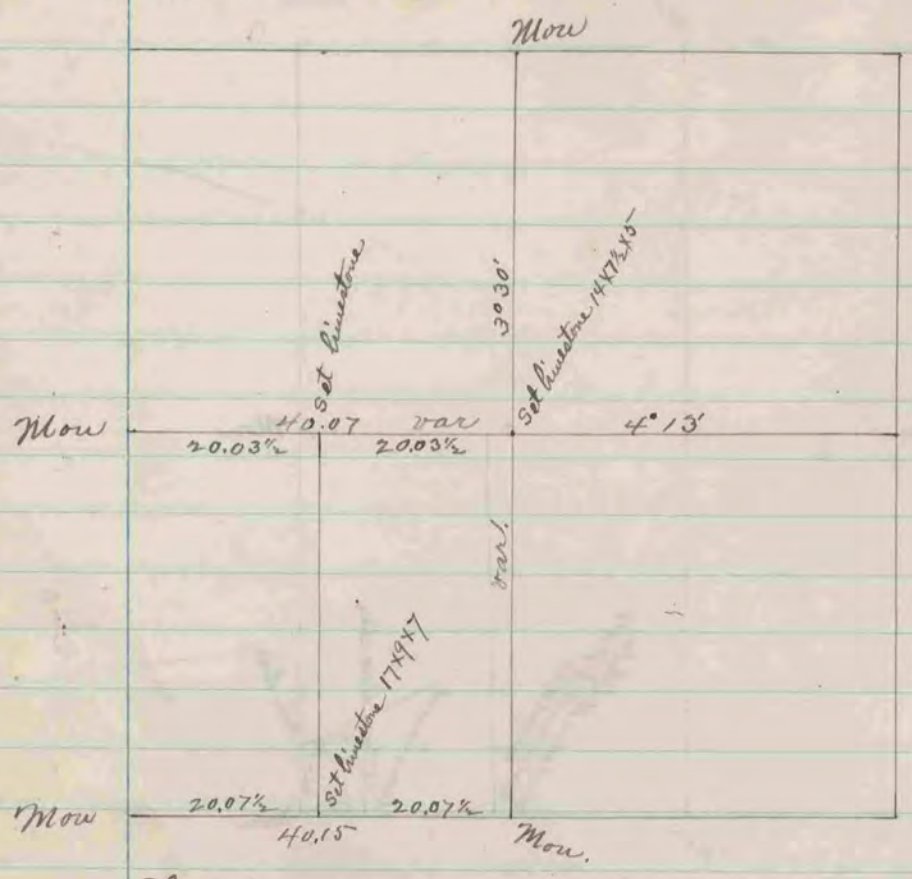

The above is a record & plat of a survey made by me on section 31 La Prairie Oct 13, 1893

O. G. Bledsoe
County Surveyor

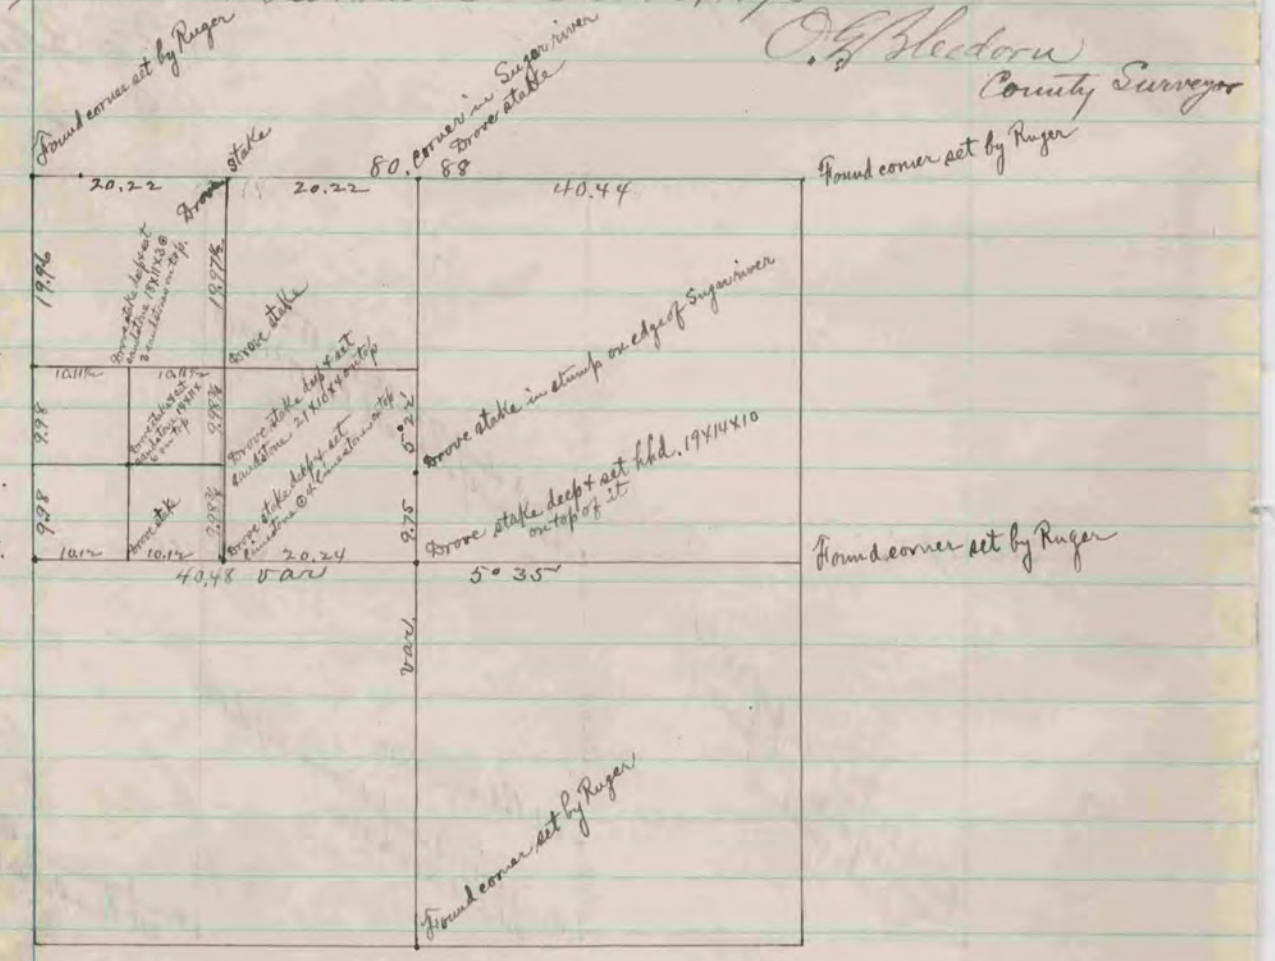

The above is a record & plat of a survey made by me on sections 15—2—9 Nov. 1 & 2, 1893

O. G. Bledsoe
County Surveyor