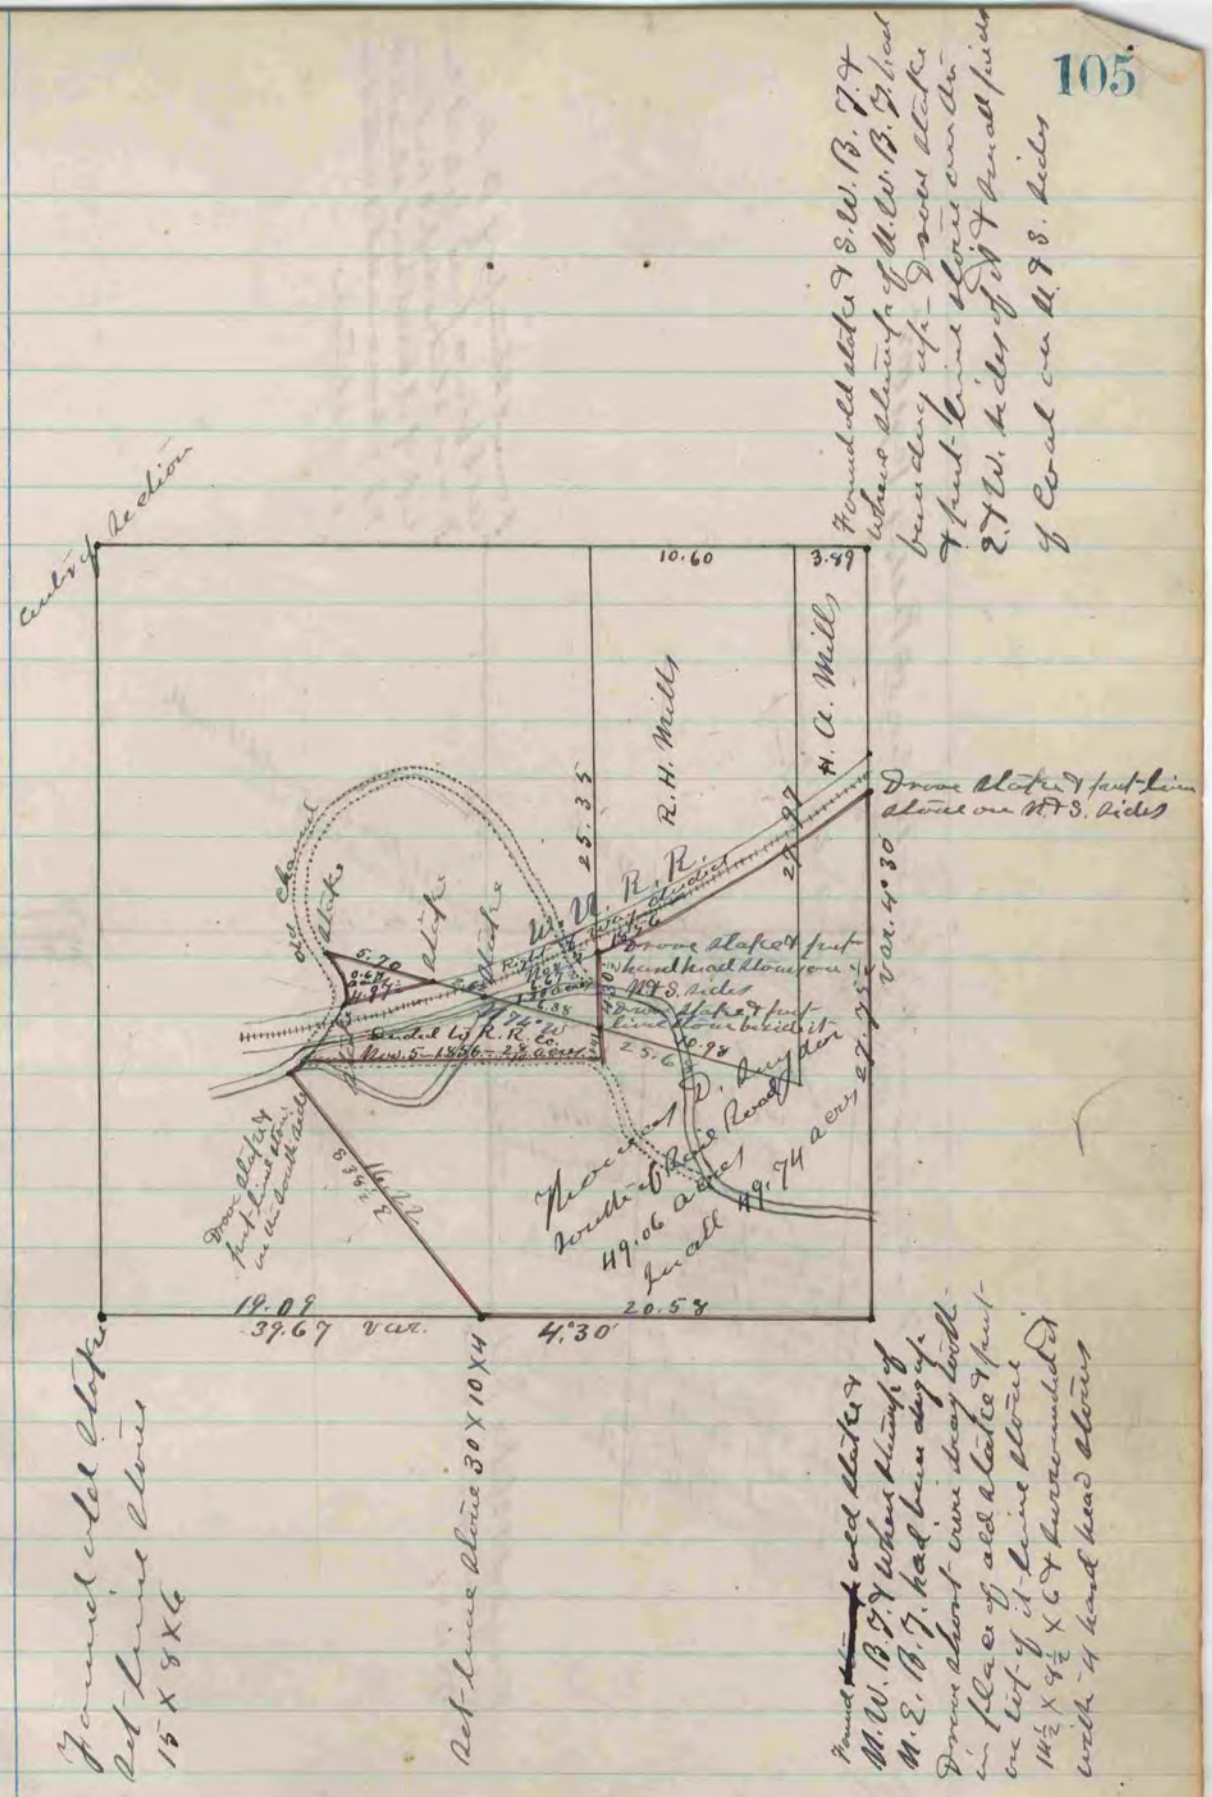

The above is a record and plot of a survey made by me on the S. E. 1/4 of Sec. 36 Beloit July 21, 22 & 24 - 1874

Edward Ruger
County Surveyor

COUNTY SURVEYOR
RECORD 2 1869-1900