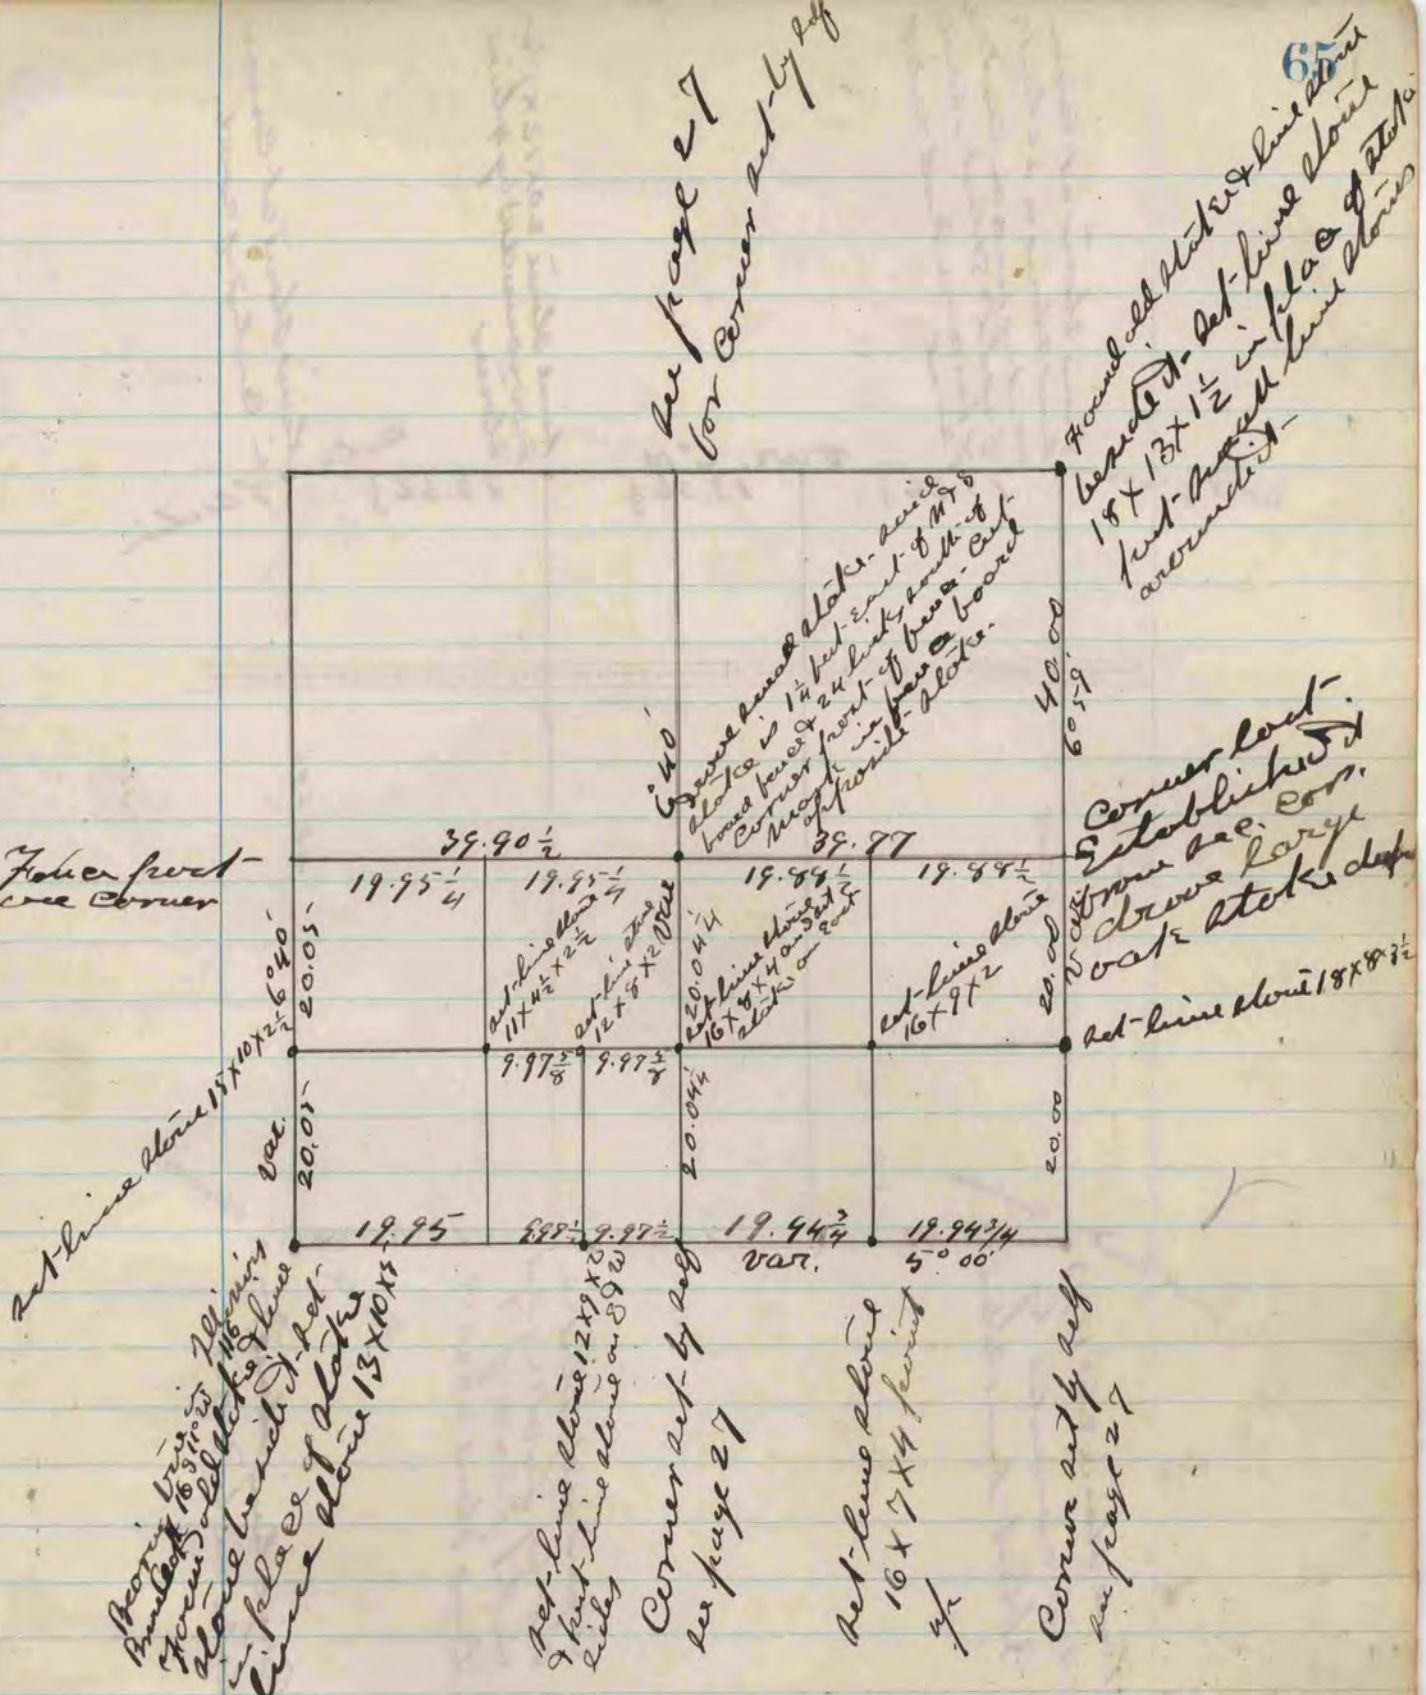

The above is a Correct Plot and Record of a Survey made by me on Section 33 of the Town of Avon - Surveyed August 1920 1920

Edward Ruger
County Surveyor

COUNTY SURVEYOR
RECORD 2 1869-1900