COUNTY SURVEYOR
RECORD 2 1869-1900

Section Avon

The above is a plat and record of a survey made by me on Section 20 Avon May 19th & 20th 1873.

R. K. Lee Dep. Co. Surv'r

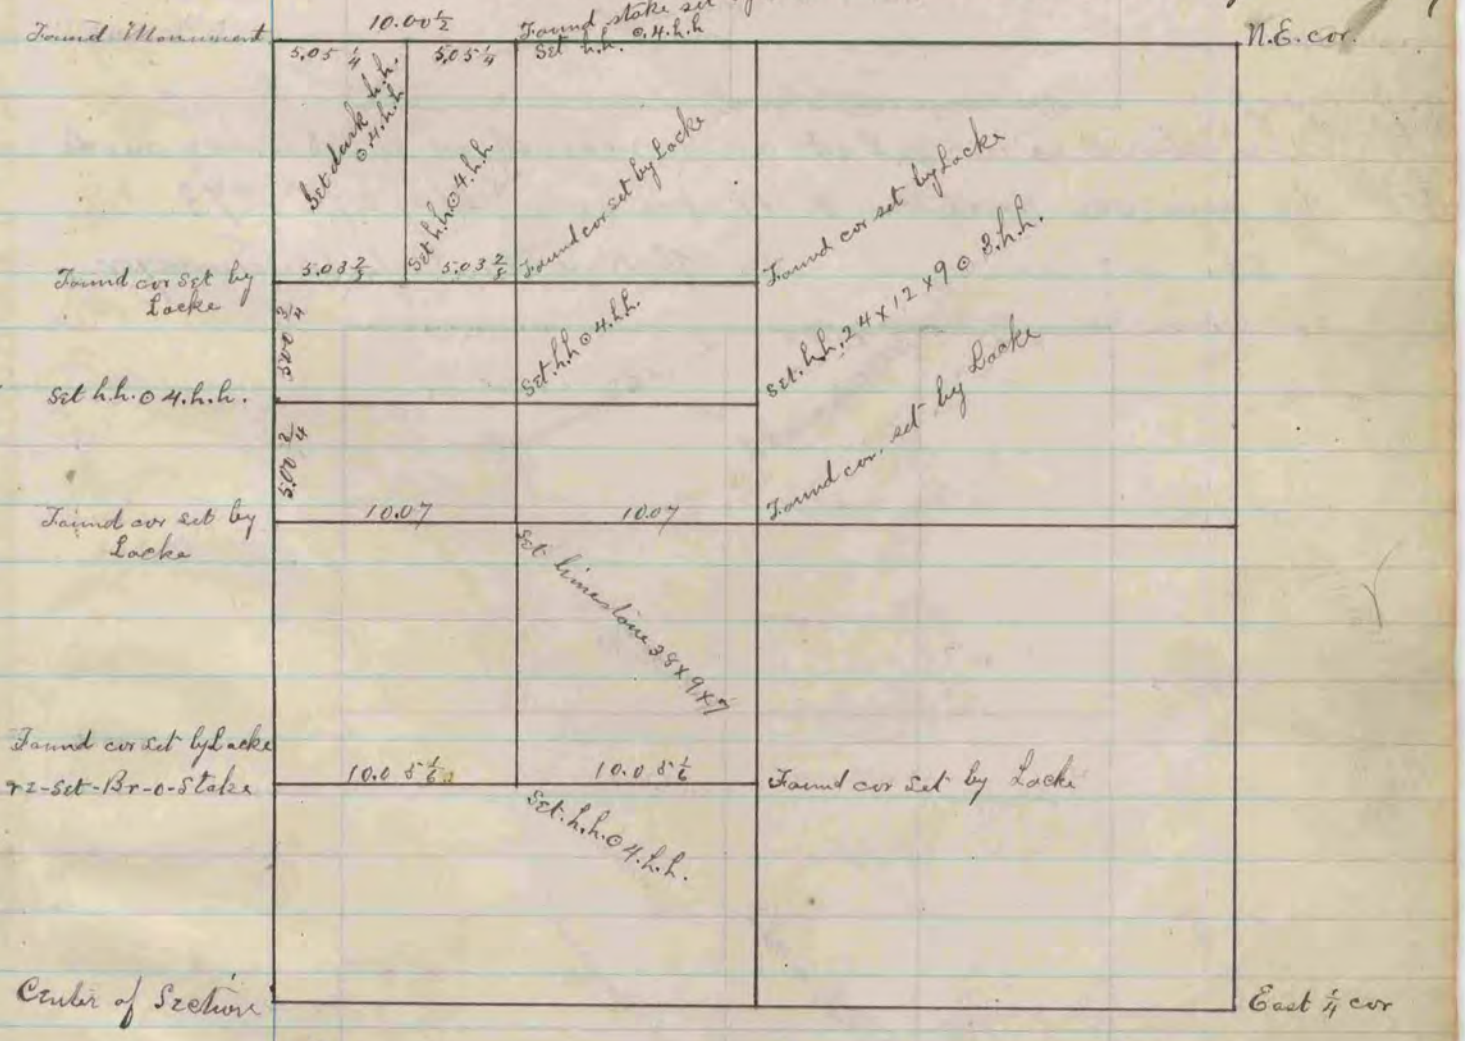

The above is a plat and record of a Survey made by me on Section 15 Harmony May 26th 1873

R. K. Lee

Dep. Co. Surveyor

Sec 15 Harmony
Surveyed May 26 1873