COUNTY SURVEYOR
RECORD 2 1869-1900

Taken from notes of C.H.G. Bleecker.

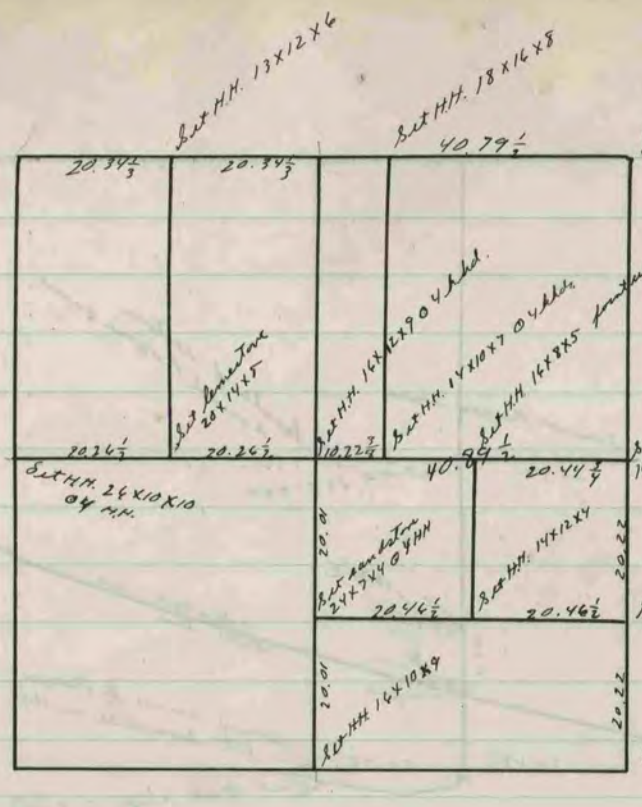

Sect. 17, Porter

Aug 15 1895

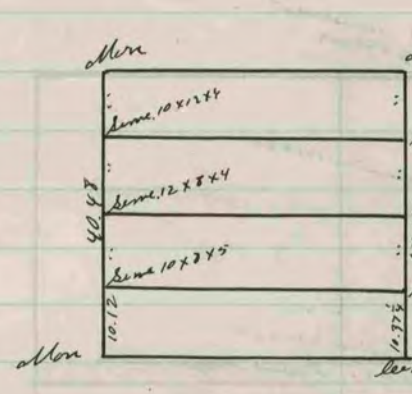

N. W. ¼ Sect 2 La Prairie

Sept 4 1895

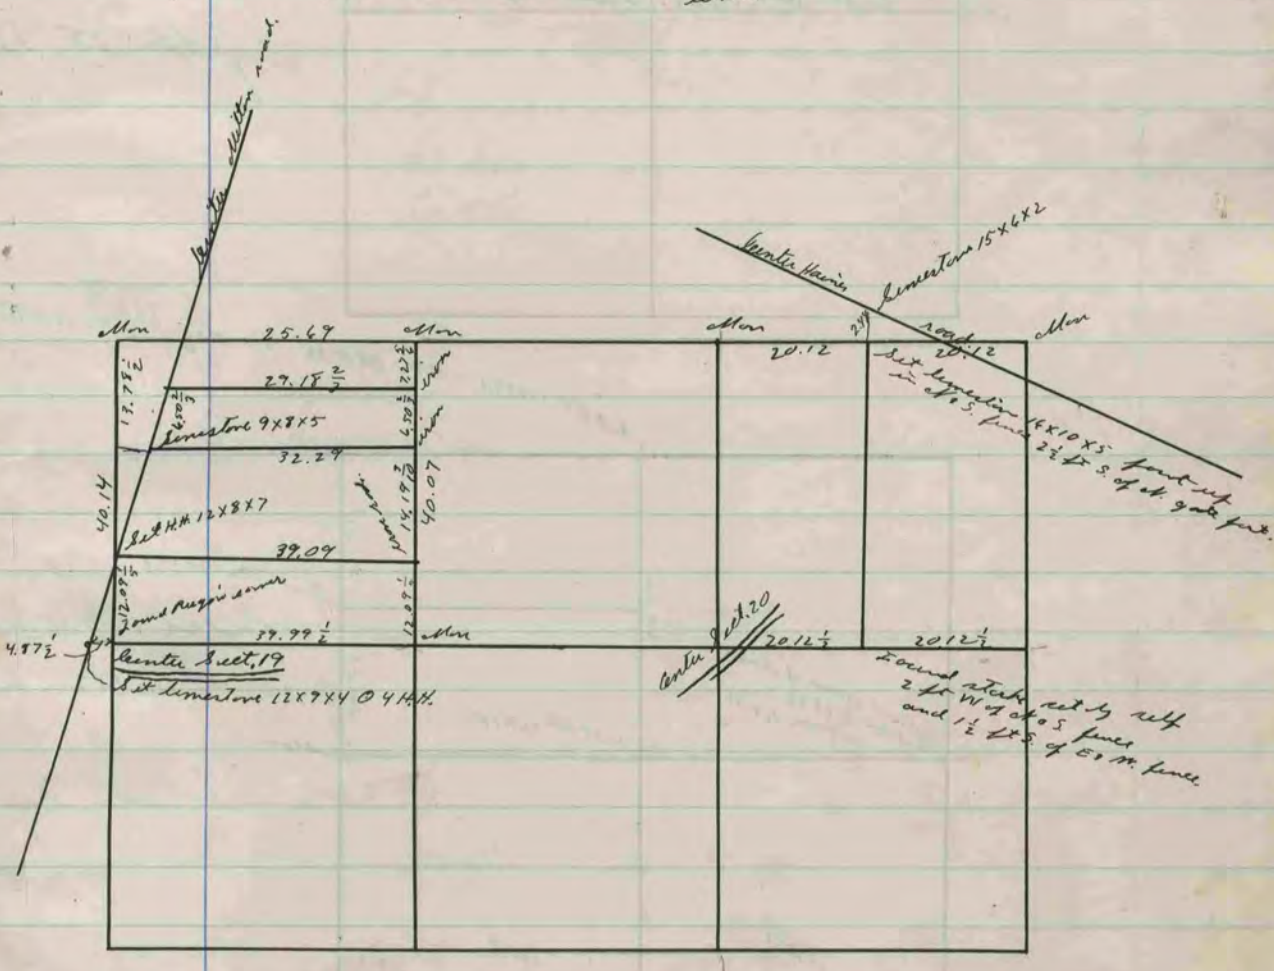

Sections 19. & 20. Harmony

Sept 21 & 24 1895