COUNTY SURVEYOR
RECORD 2 1869-1900

Alle 31 [illegible]

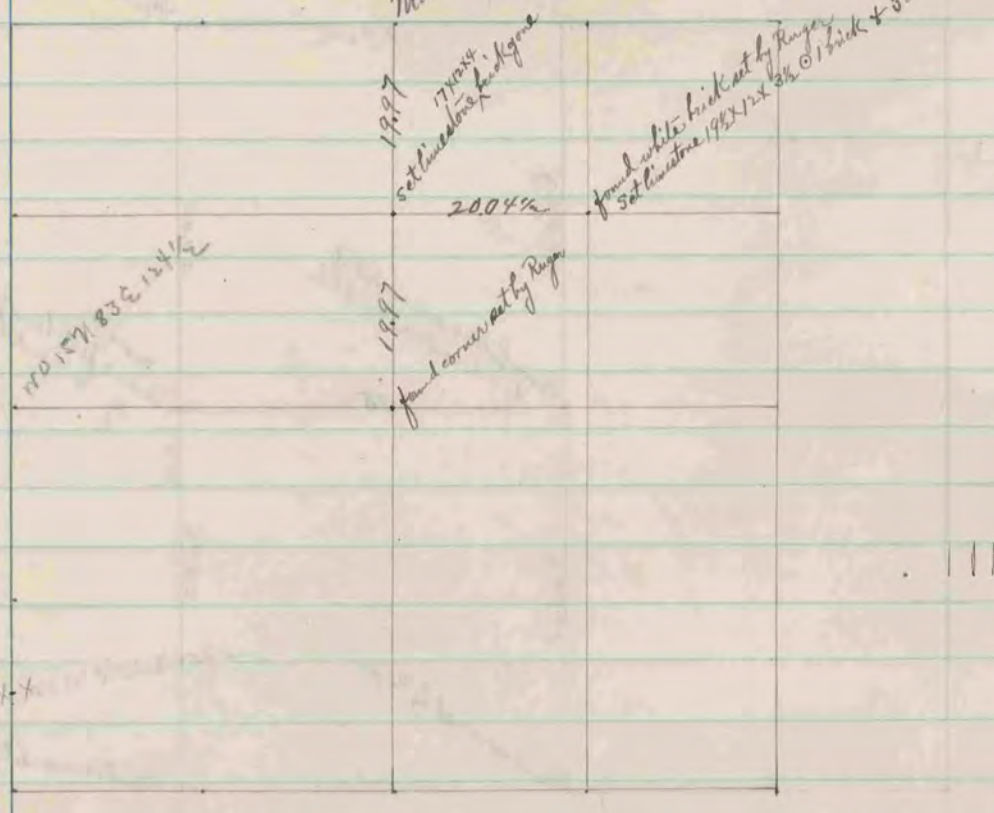

The above is a record & plat of a survey made by me on section 31 Harmony Oct. 15, 1892.

County Surveyor

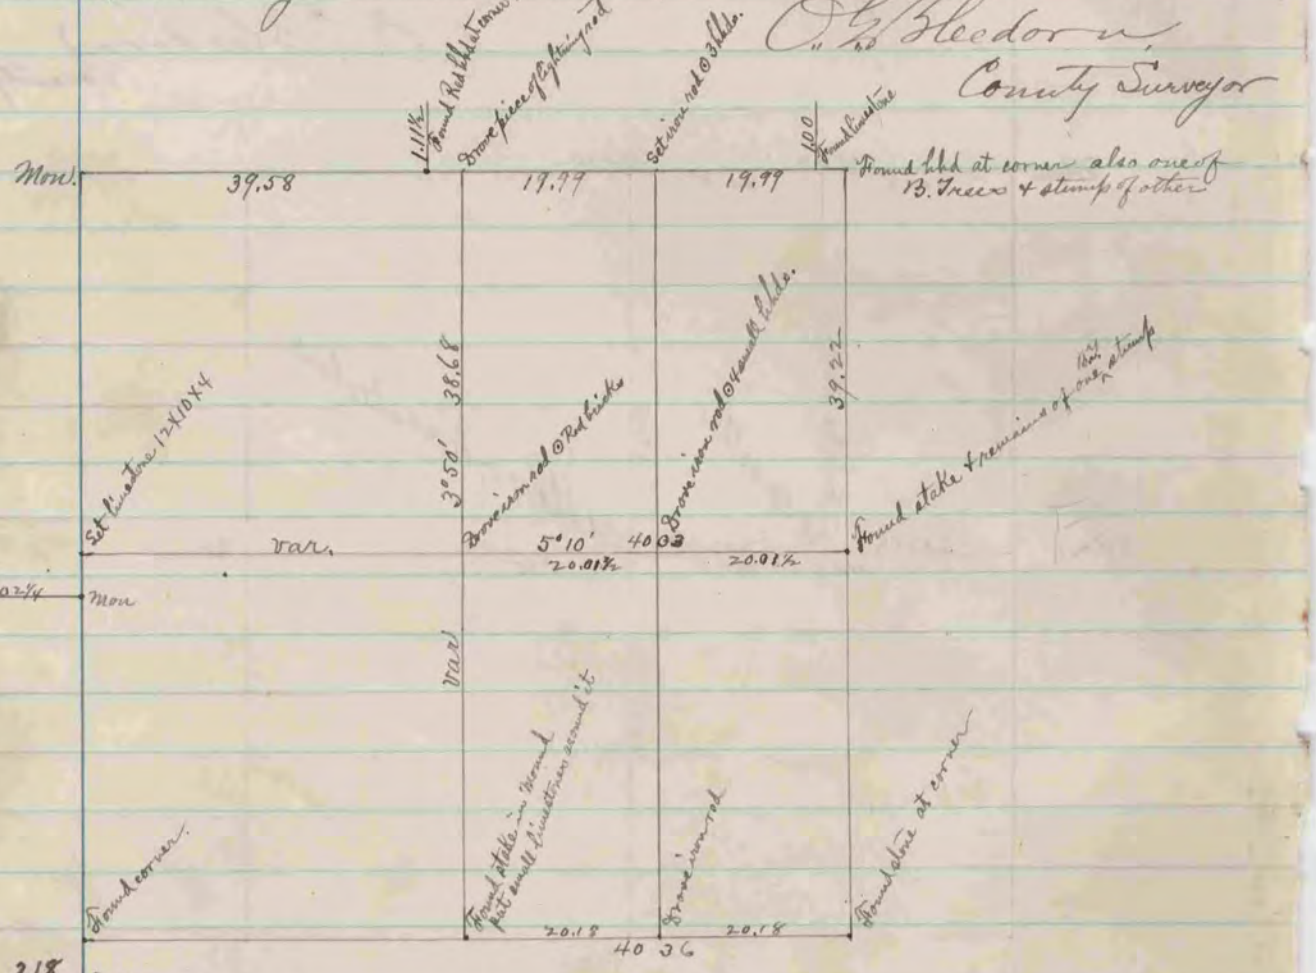

The above is a record & plat of a survey made by me on section 6 Porter March 23 & 24, 1893

County Surveyor