COUNTY SURVEYOR
RECORD 2 1869-1900

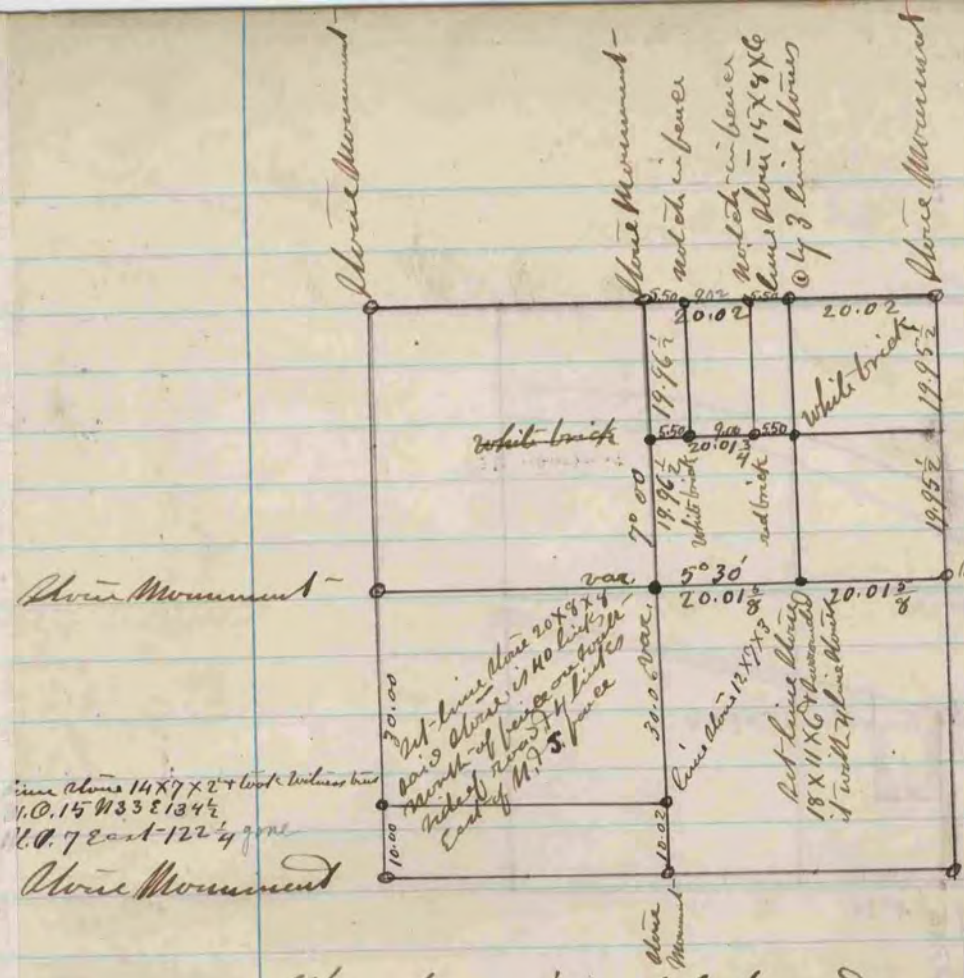

The above is a plat and record of a survey made by me on Section 31 Harmony April 3rd-1871

Edward Ryger
County Surveyor

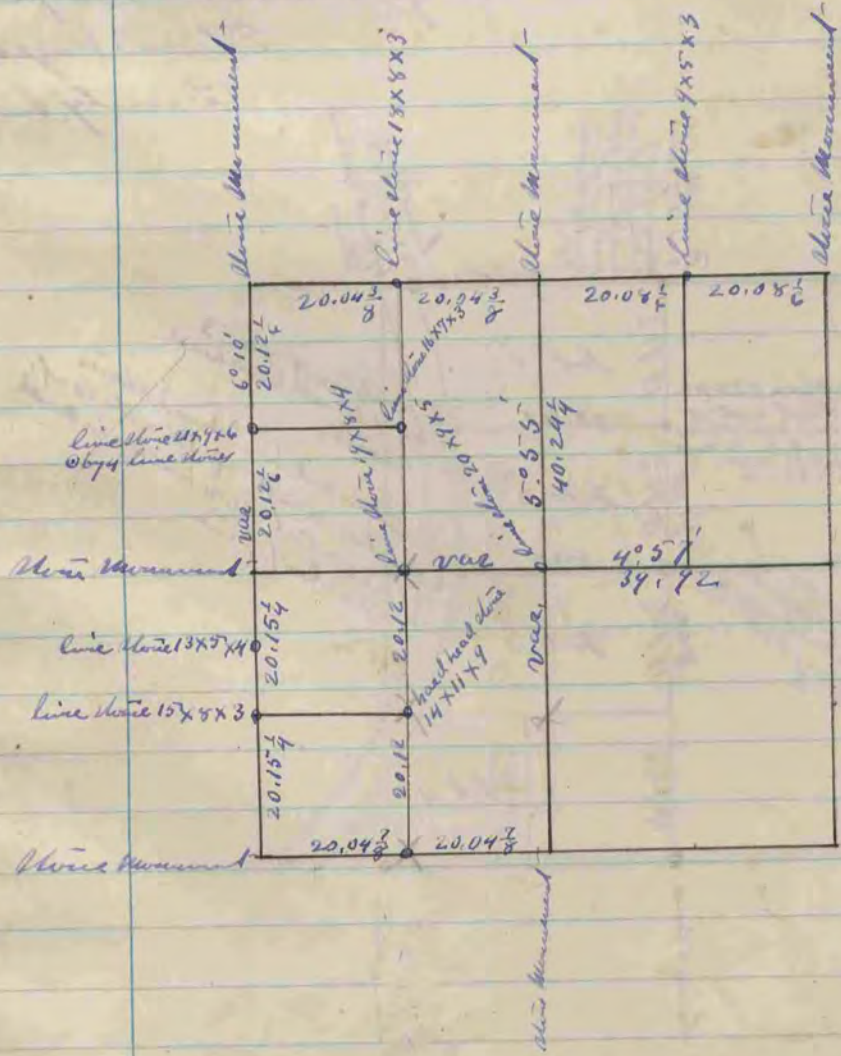

The above is a record and plat of a survey made by me on Section 15 Plymouth April 14th & 15th-1871

Edward Ryger
County Surveyor