COUNTY SURVEYOR
RECORD 1859-1906

(Recorded in Vol I page 215)

A Record & Plat of a Survey made on Sec. 7. T. 3. R. 12 E. June 23 & 24. 1864. by S. H. Locke County Surveyor for Rock Co. Wis.

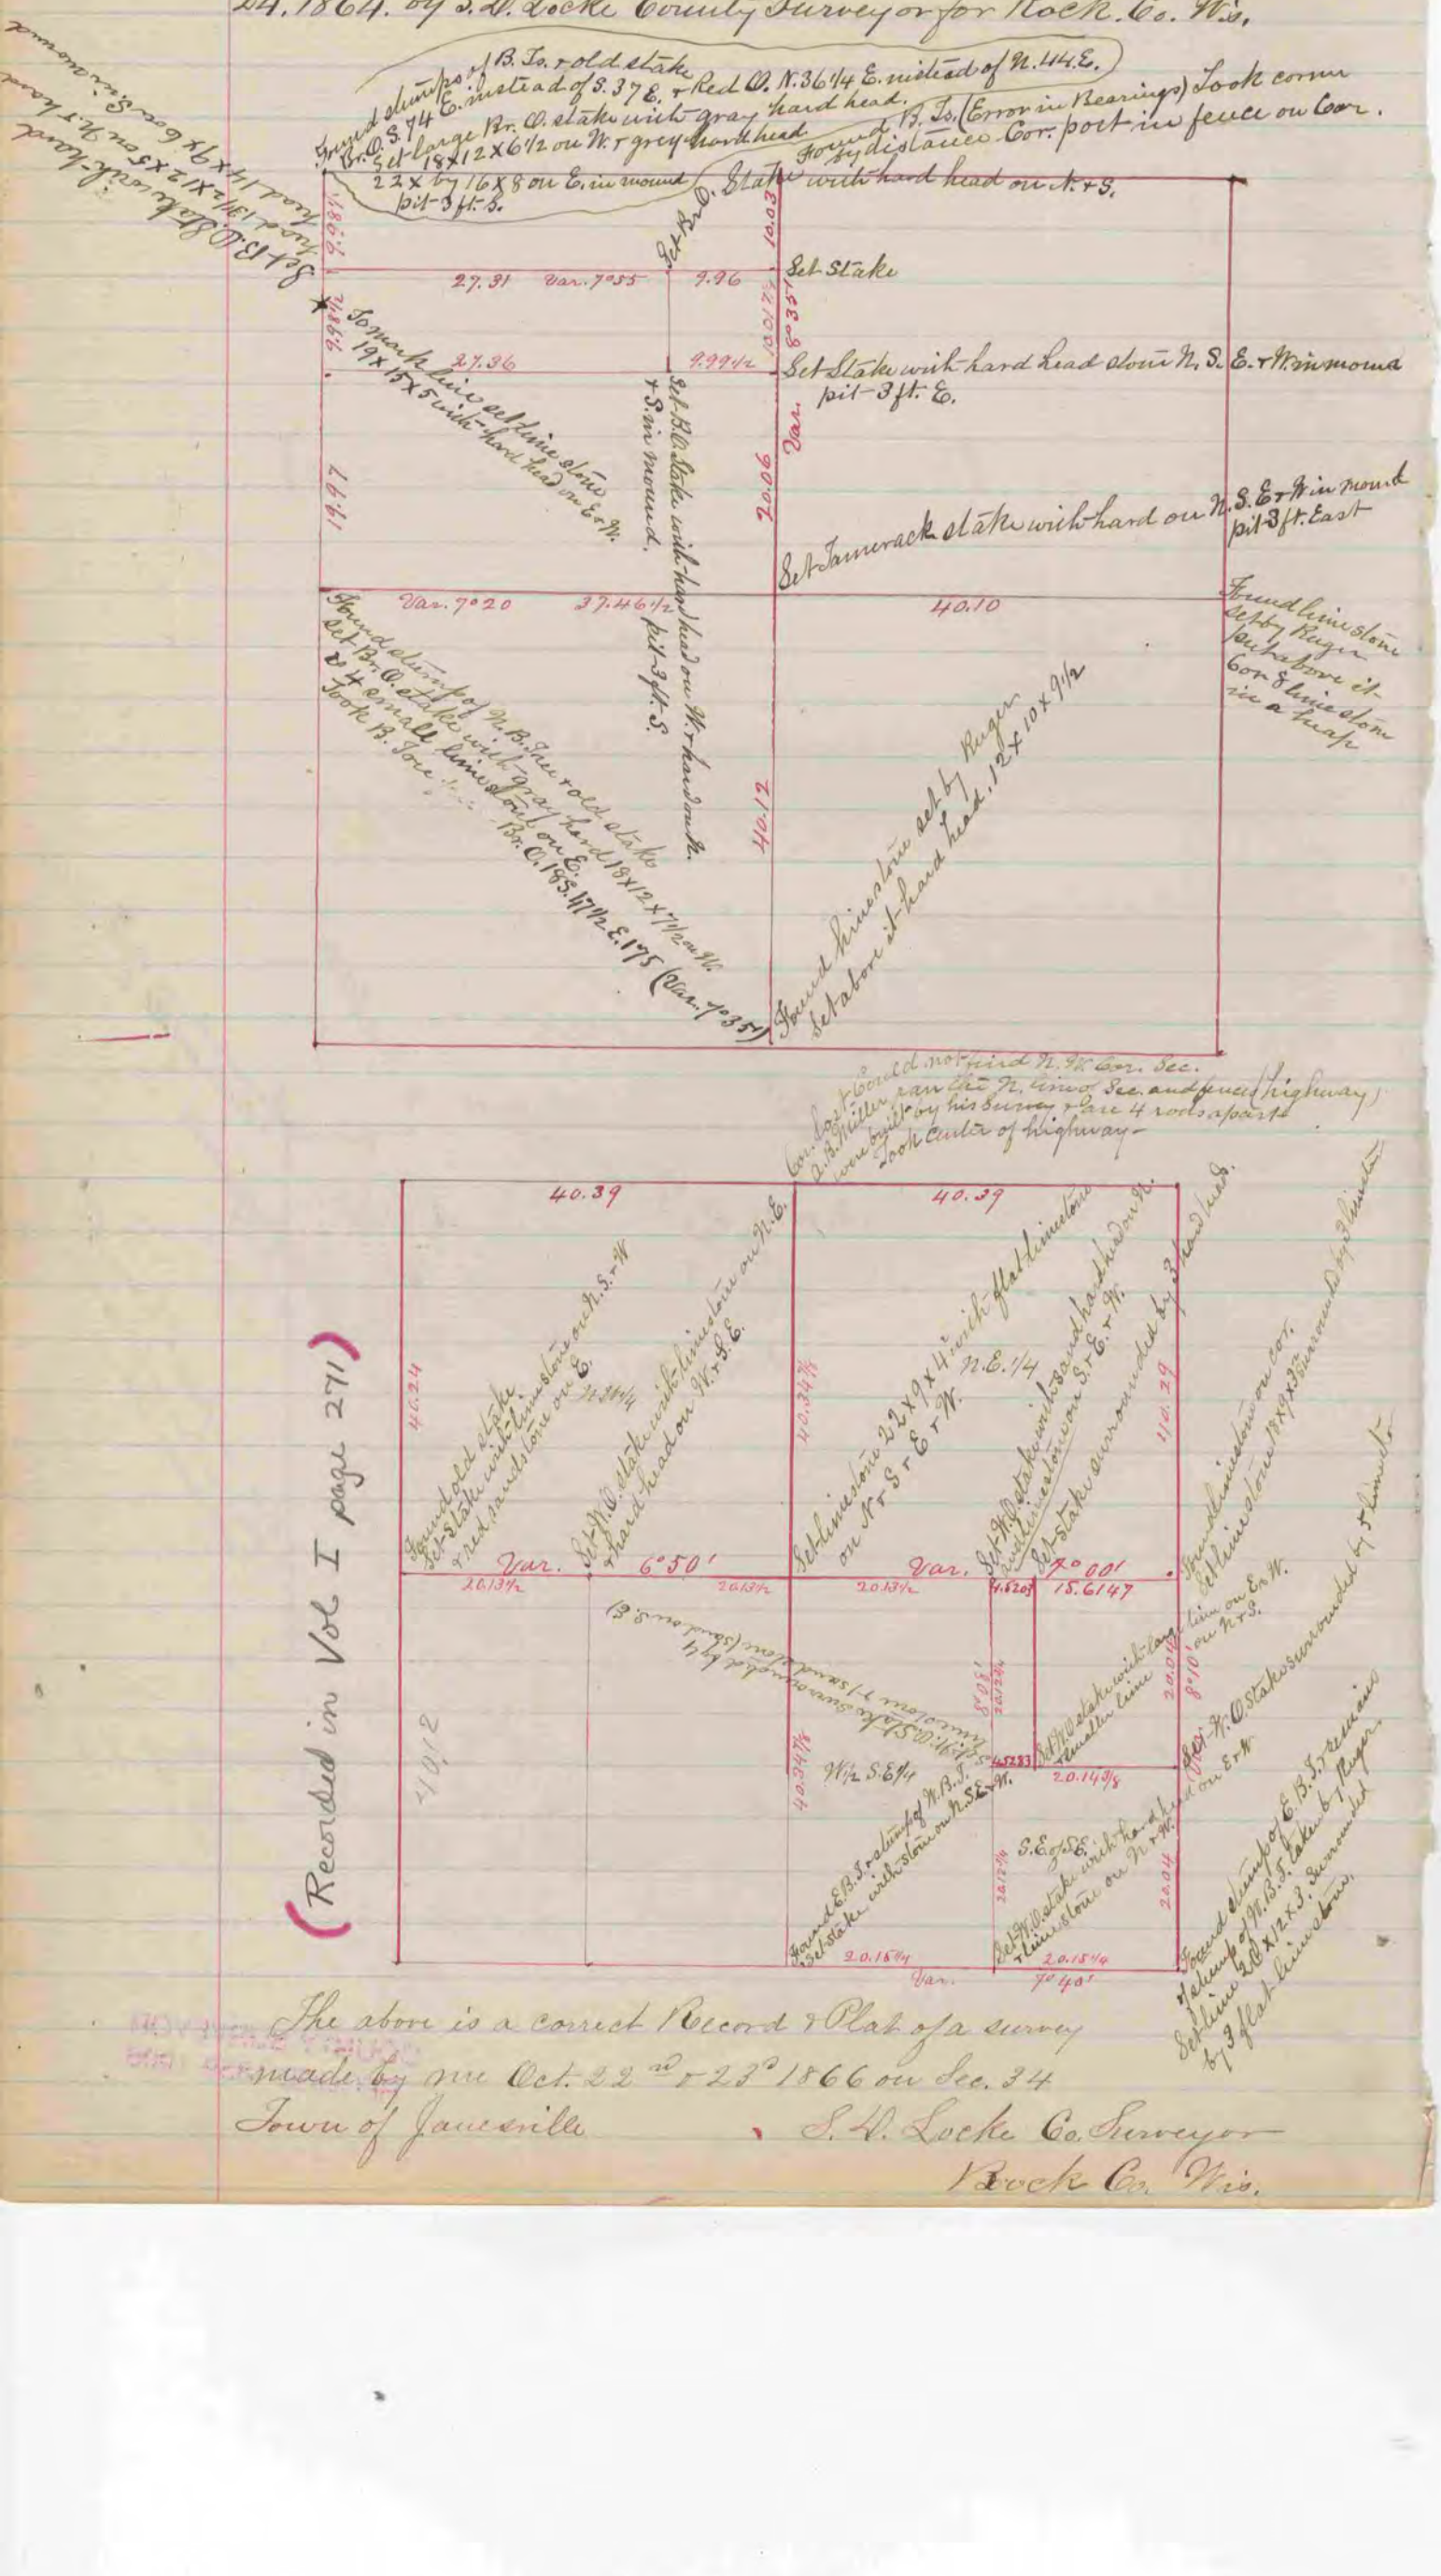

(Recorded in Vol I page 271)

The above is a correct Record & Plat of a survey made by me Oct. 22nd & 23d 1866 on Sec. 34 Town of Janesville

S. H. Locke Co. Surveyor
Rock Co. Wis.