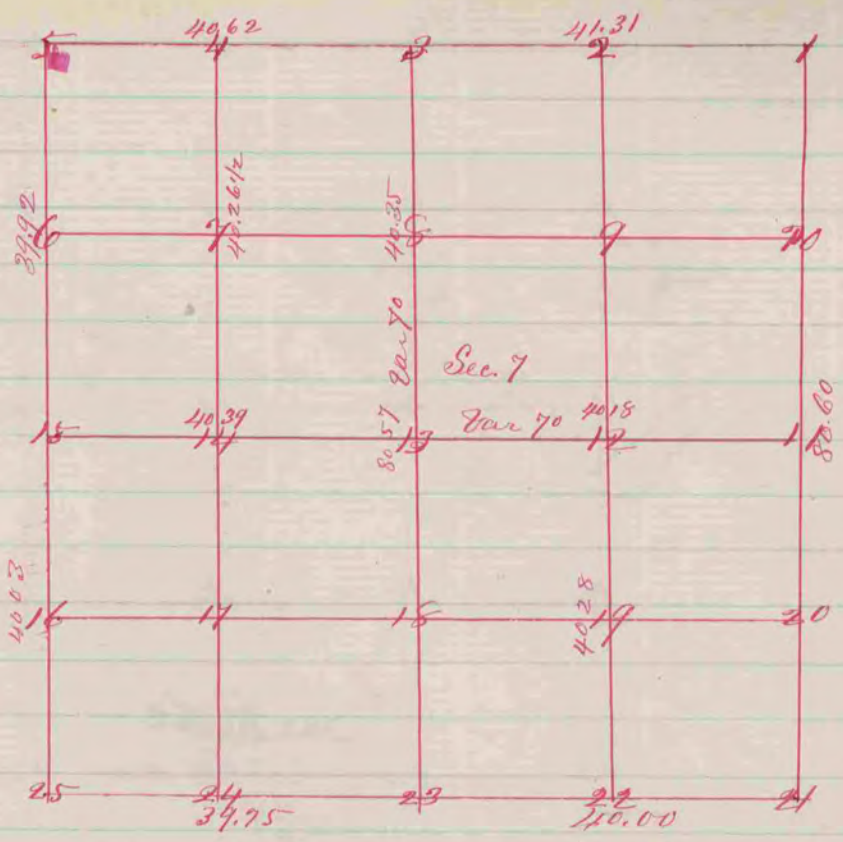

Fig 13 Represent the Centre of the Section
" " Gel. O 10 N 49 1/3 W 1.59 Also Gel. O 10 N. 59 1/3 W 227 1/2
" 10 " " 8 N 22 W 227 " " " " " 40 1/2 W 2.44
The above survey was made on Sec. 7
Jan. 2 & 3 1852 - Avon

Peter McLean Co Surveyor

COUNTY SURVEYOR
RECORD 1859-1906