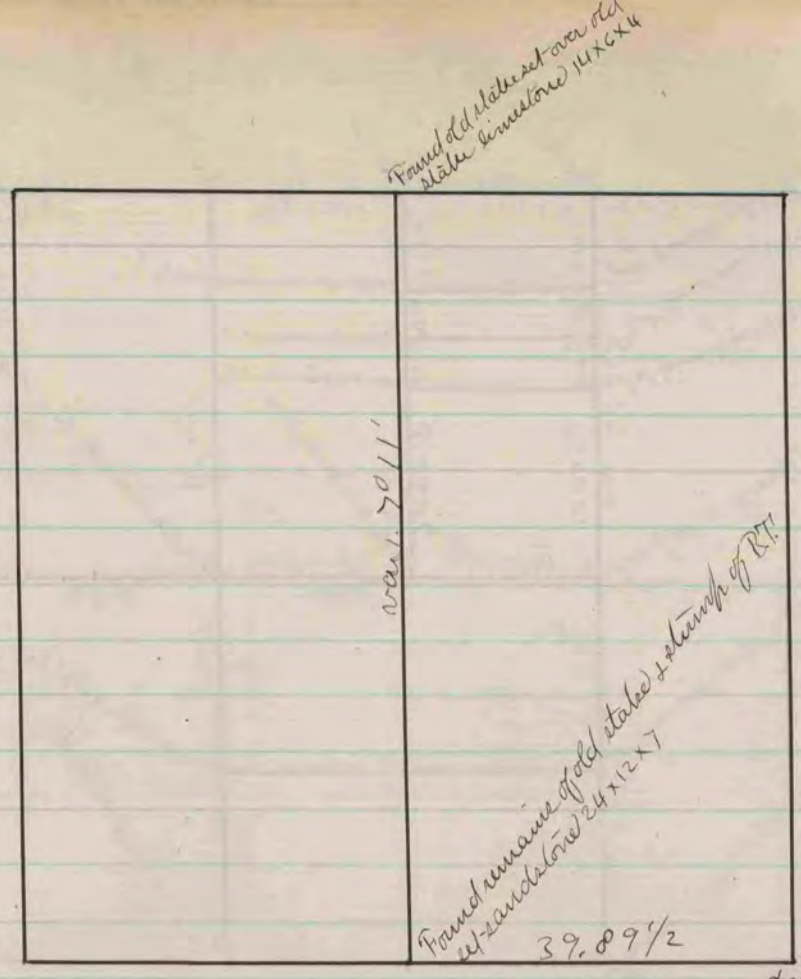

The above is a plat & record of a survey made by me July 19. 1870. on Sec. 33. Town Edward Ruger Asst Geo. Surveyor

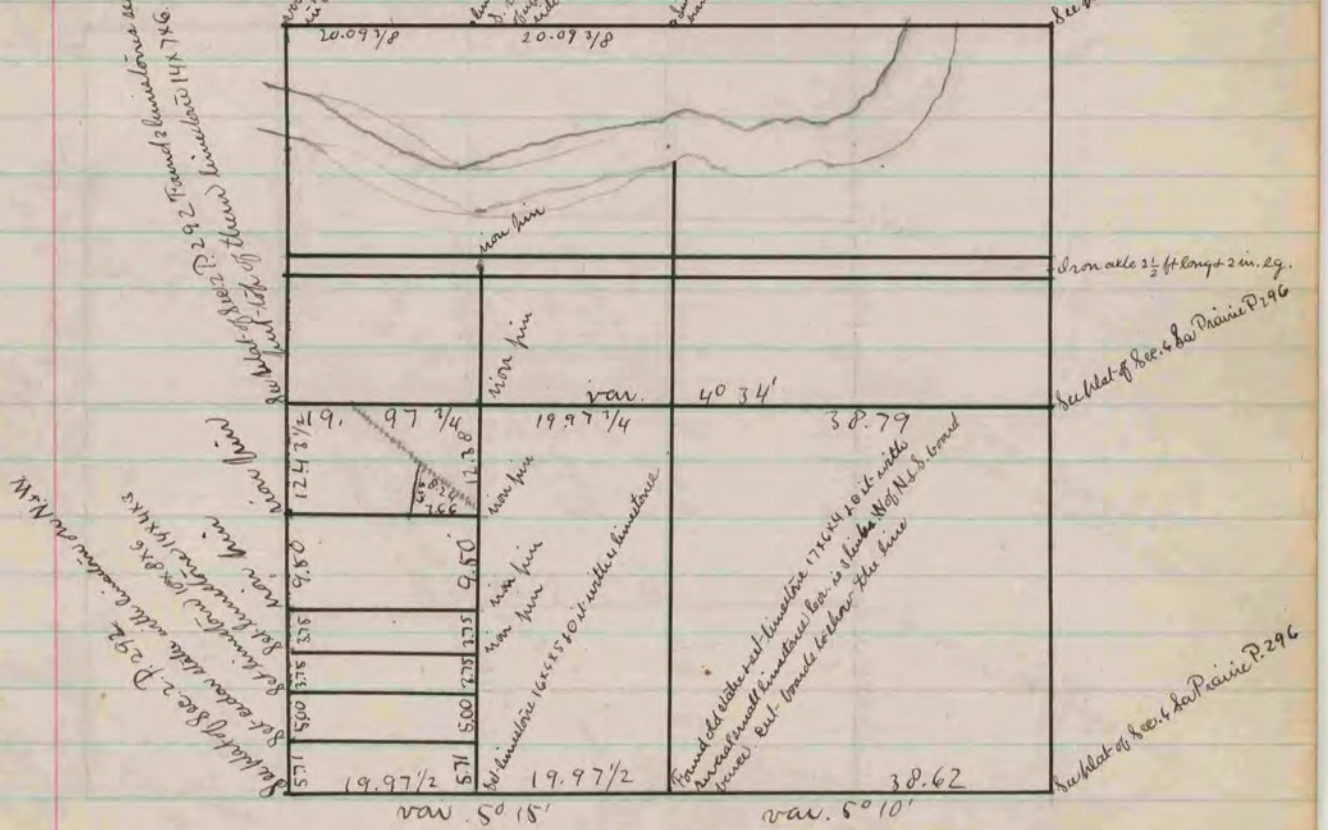

The above is a plat & record of a survey made by me on Sec. 1 Rock. Sept. 26. 1870. & Jan. 6 & 7. 1874 & Nov. 14, 1874 & April 27. 1877. Edward Ruger

Asst. Geo. Surveyor & Asst. Surveyor.

Asst. Geo. Surveyor.

COUNTY SURVEYOR
RECORD 1859-1906