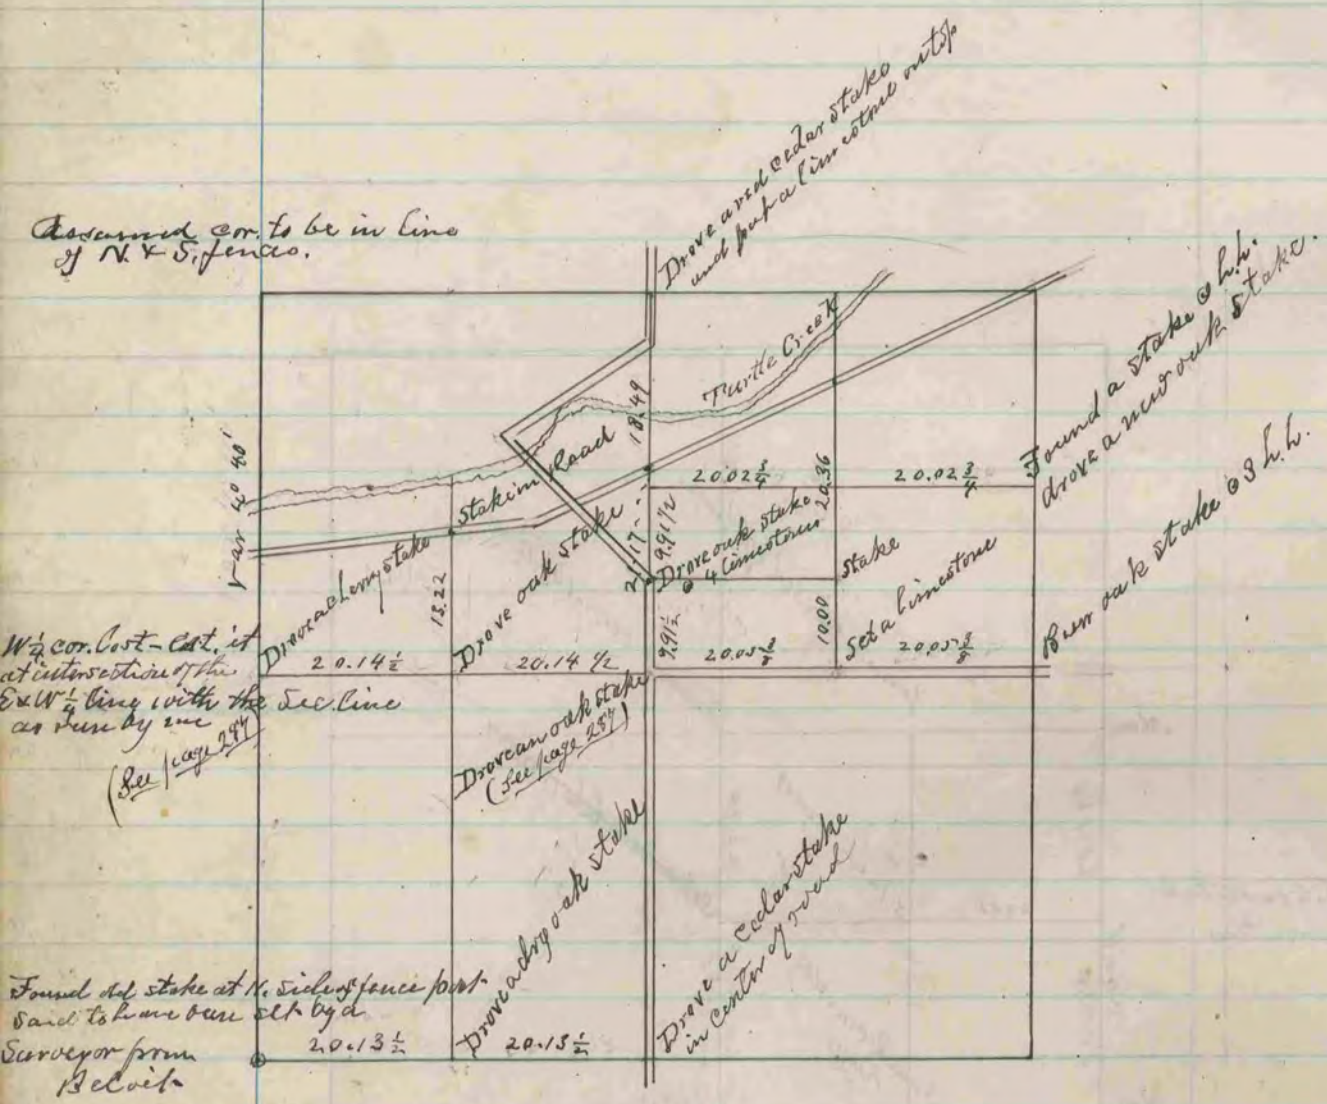

Assumed cor. to be in line of N. & S. fences.

W¼ cor. Cost - Cor. set at intersection of the E & W¼ line with the Sec. line as run by me (See page 294)


The above is a record and plat of a Survey made by me March 16th 17th & 18th 1852 on Section 9 Turtle

R. K. Lee
Dep. Co. Surveyor.

COUNTY SURVEYOR
RECORD 2 1869-1900