COUNTY SURVEYOR
RECORD 2 1869-1900

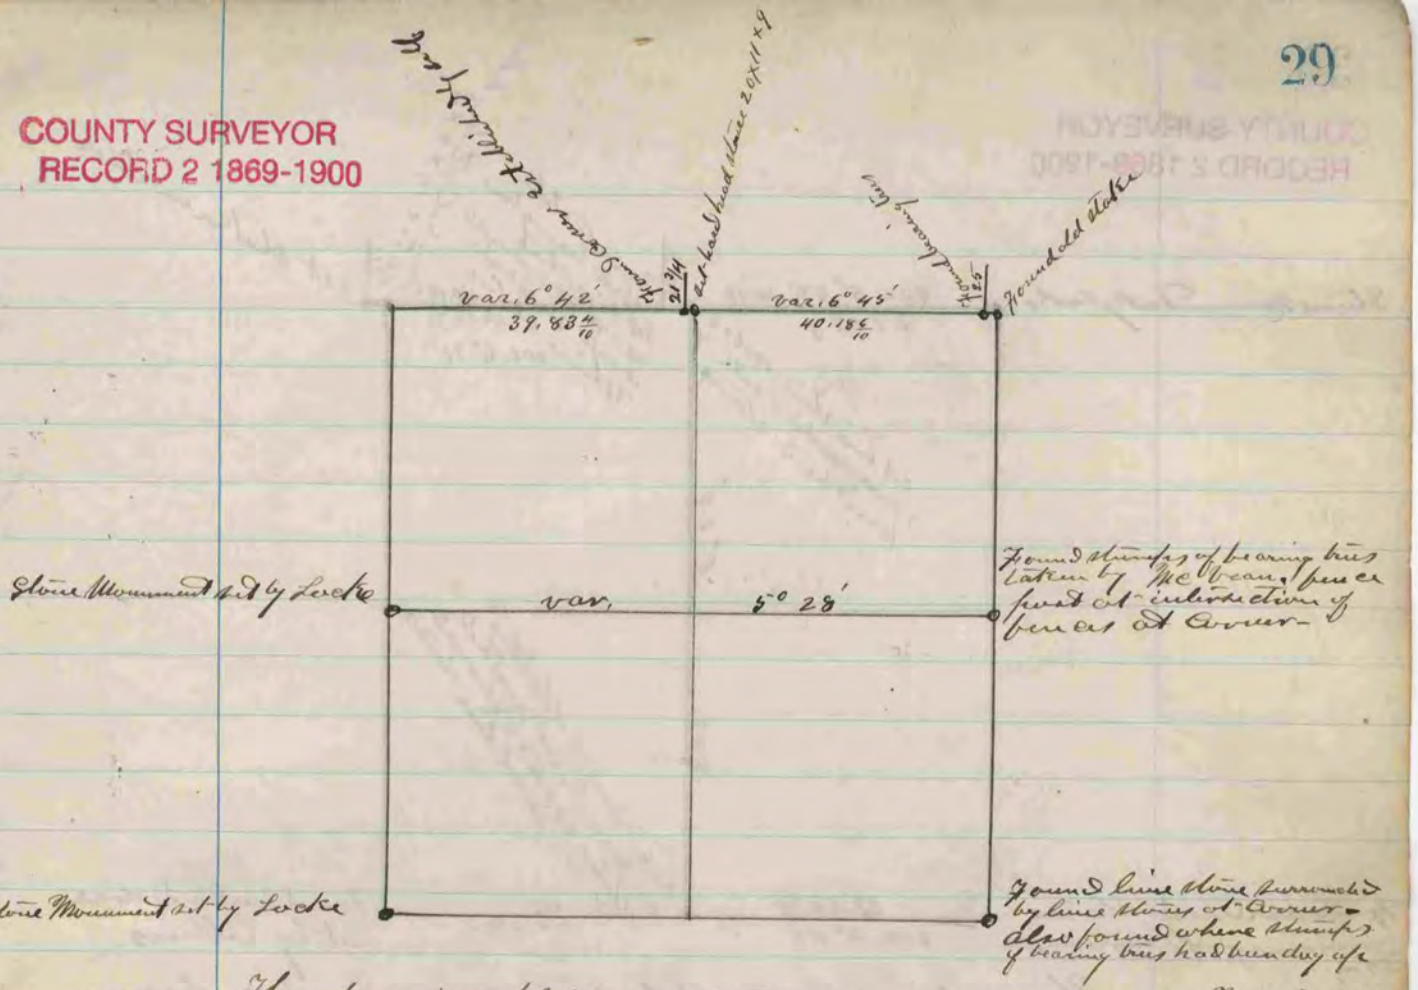

The above is a plot & record of a survey made by me, Nov. 9 & 10, 1870 on Section 6 Rock

Edward Ruger
Dept. County Surveyor

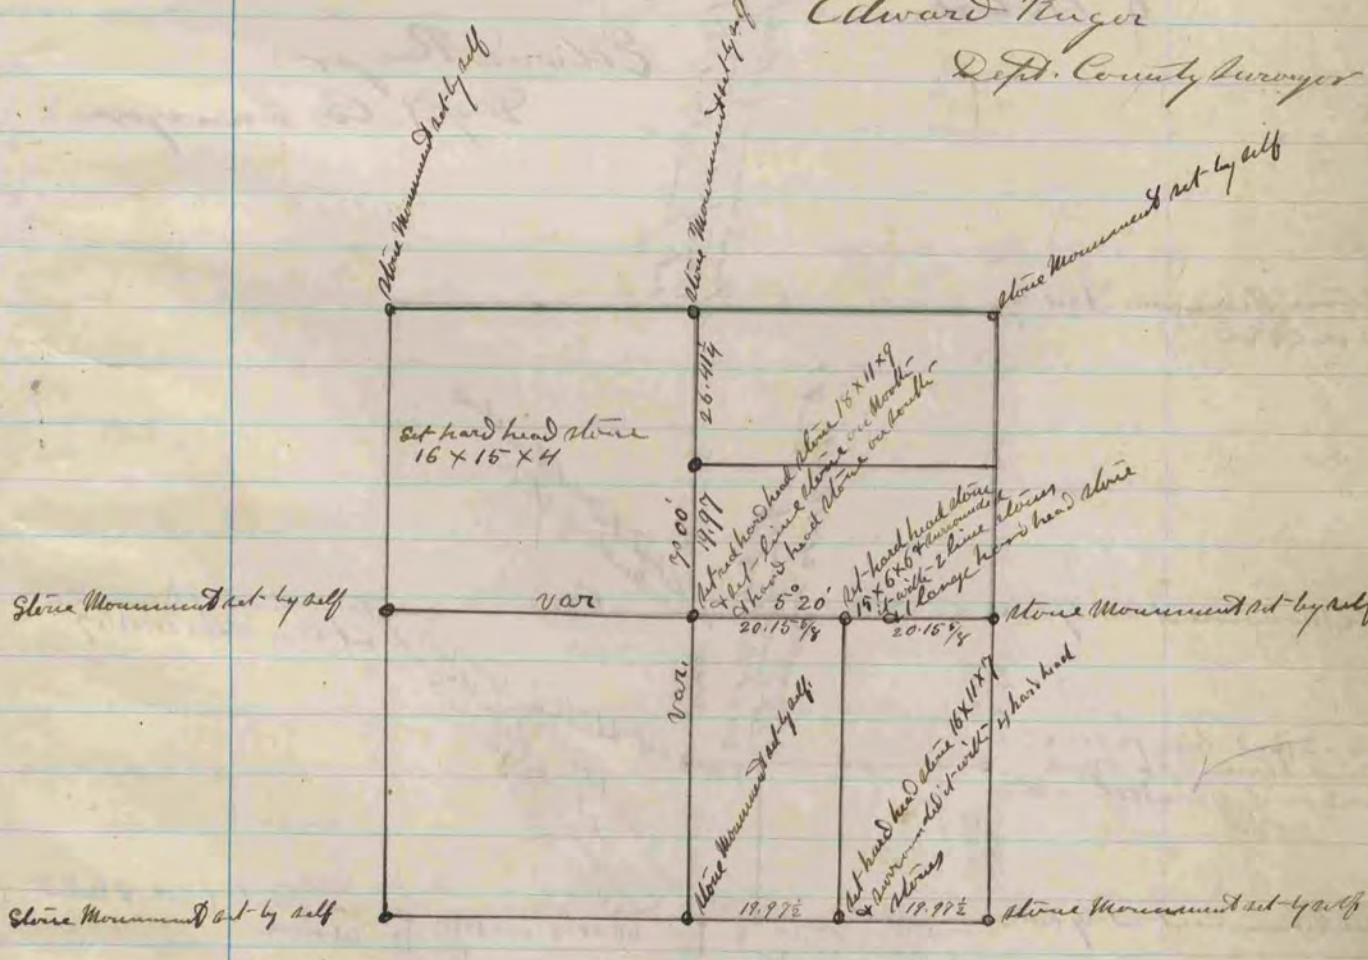

The above is a plot & record of a survey made by me, Nov. 16, 1870, on Section 4 Harmony

Edward Ruger
Dept. Co. Surveyor