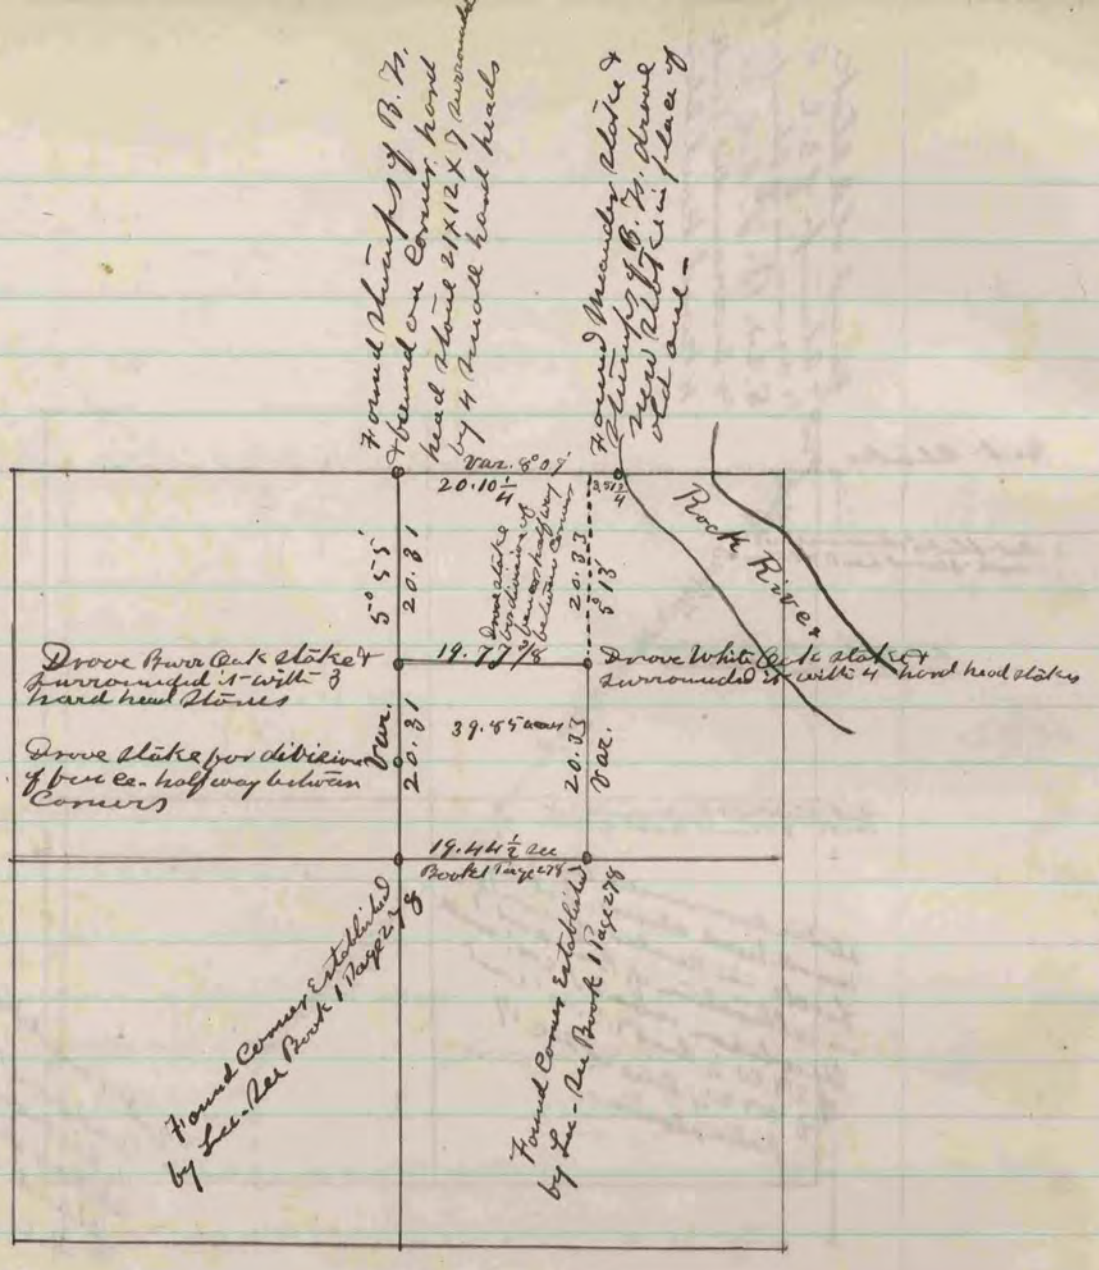

The above is a Correct Plat and Record of a Survey made by me on Sections 6 of the Town of Yarnville Surveyed July 10 & 11 1873

Edward Rugee
County Surveyor

COUNTY SURVEYOR
RECORD 2 1869-1900