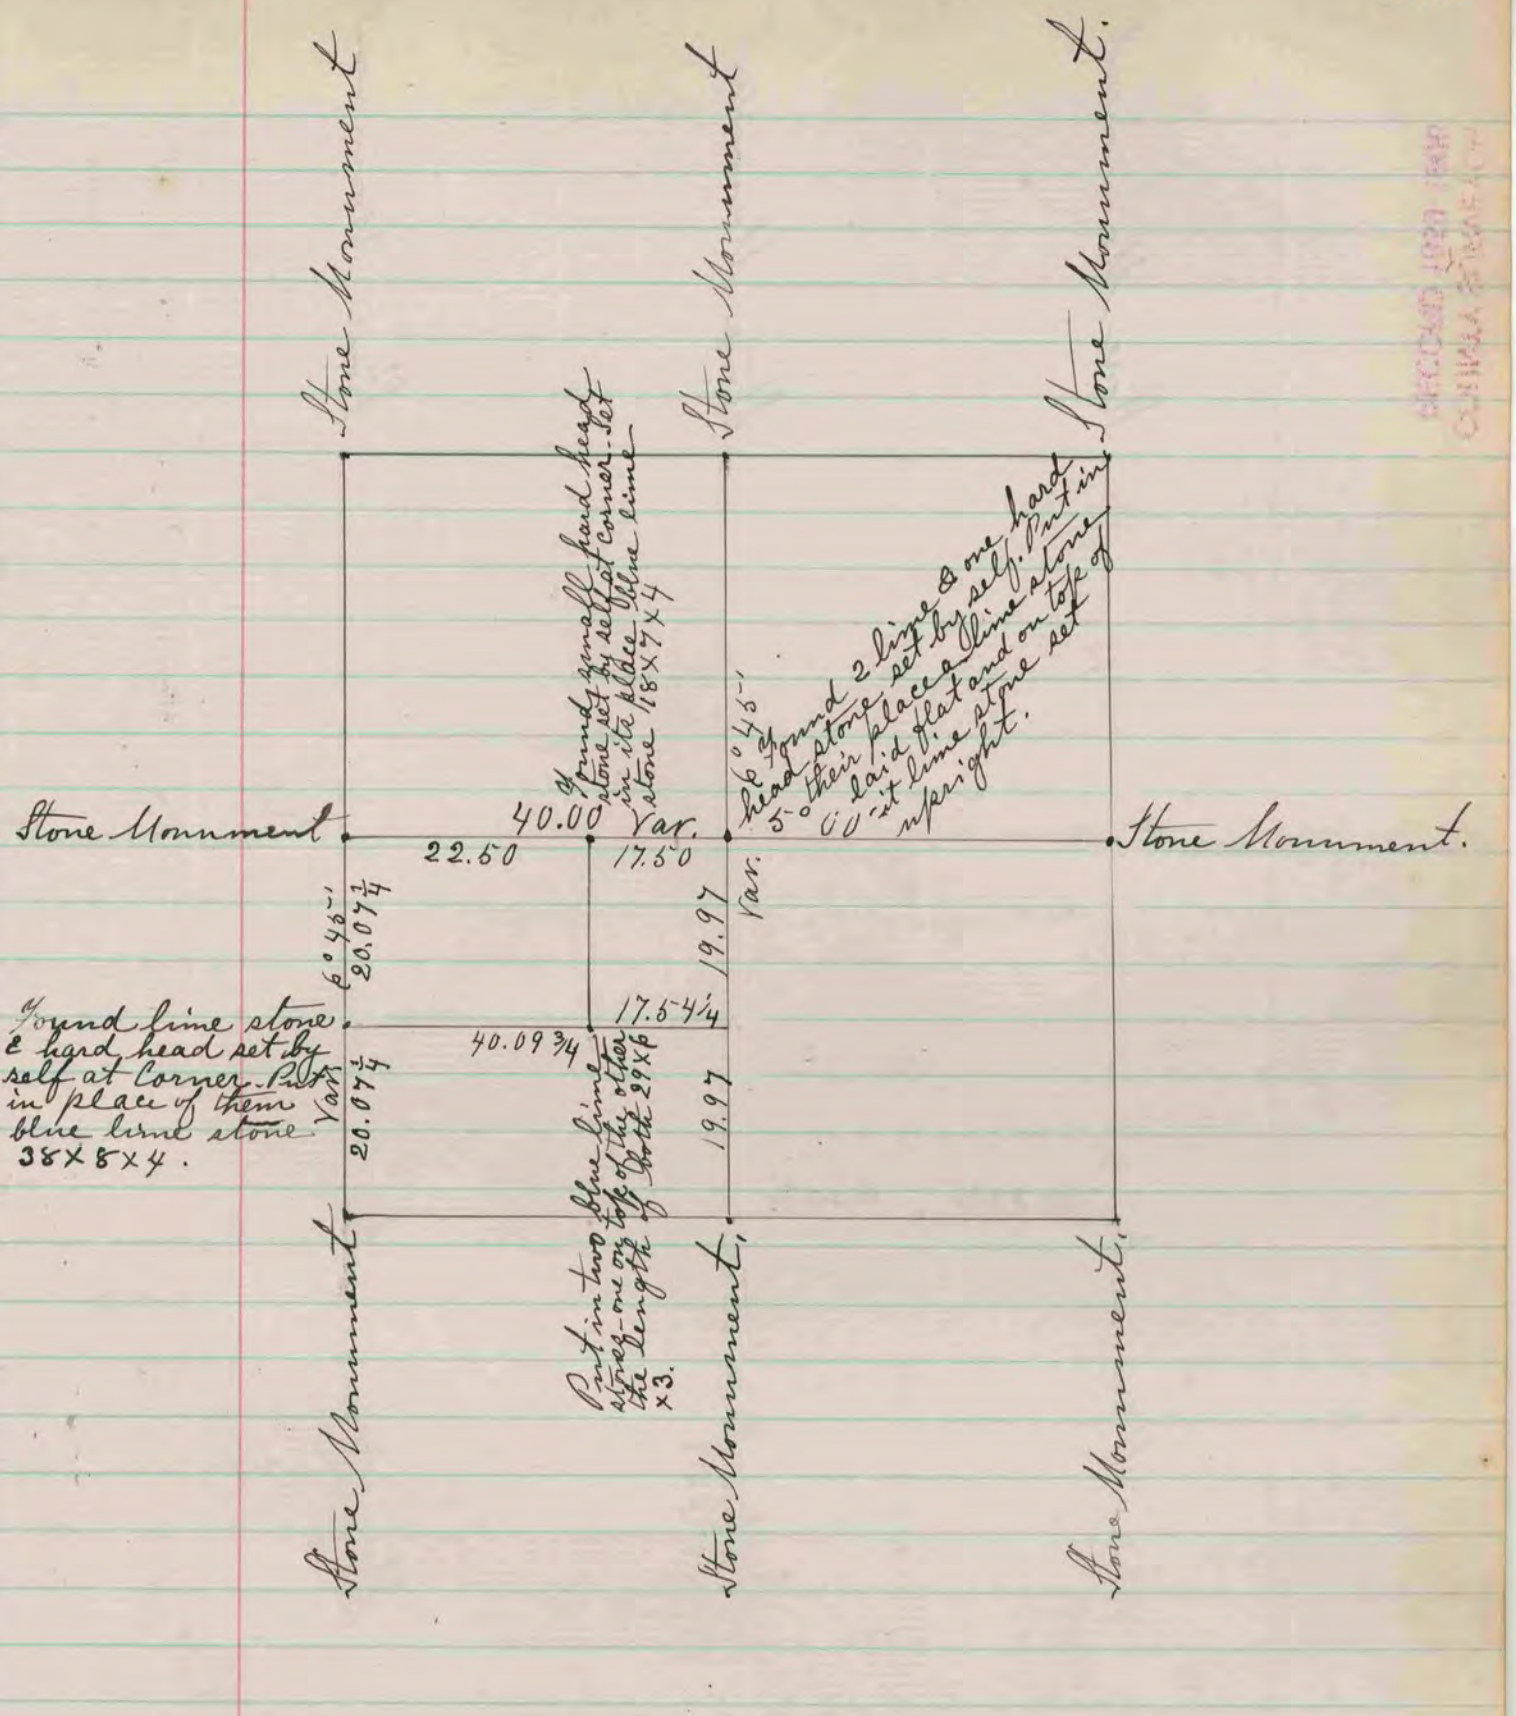

The above is a record and plat of a Survey made by me on Section 35 Harmony - May - 18 - 1874

Edward Ruger
County Surveyor -

COUNTY SURVEYOR
RECORD 1859-1906