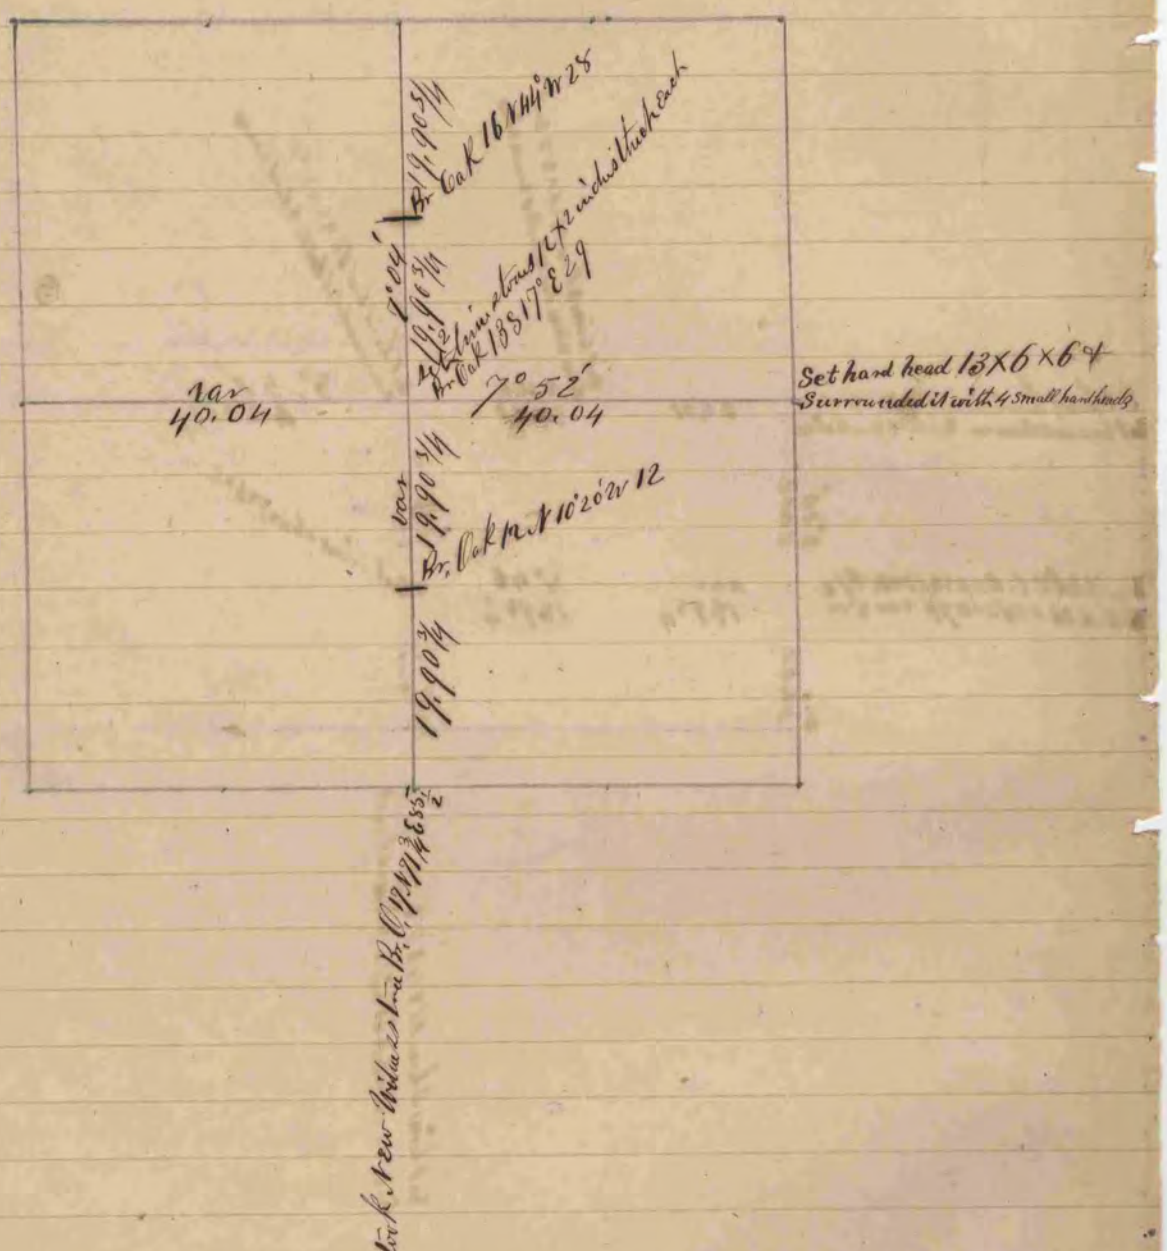

A record and plot of a survey made on the 22nd day of March 16th A.D. 1861 by Edward Rugles County Surveyor for Rock County Wis

Fulton

COUNTY SURVEYOR
RECORD 1 1851-1869