COUNTY SURVEYOR
RECORD 1859-1906

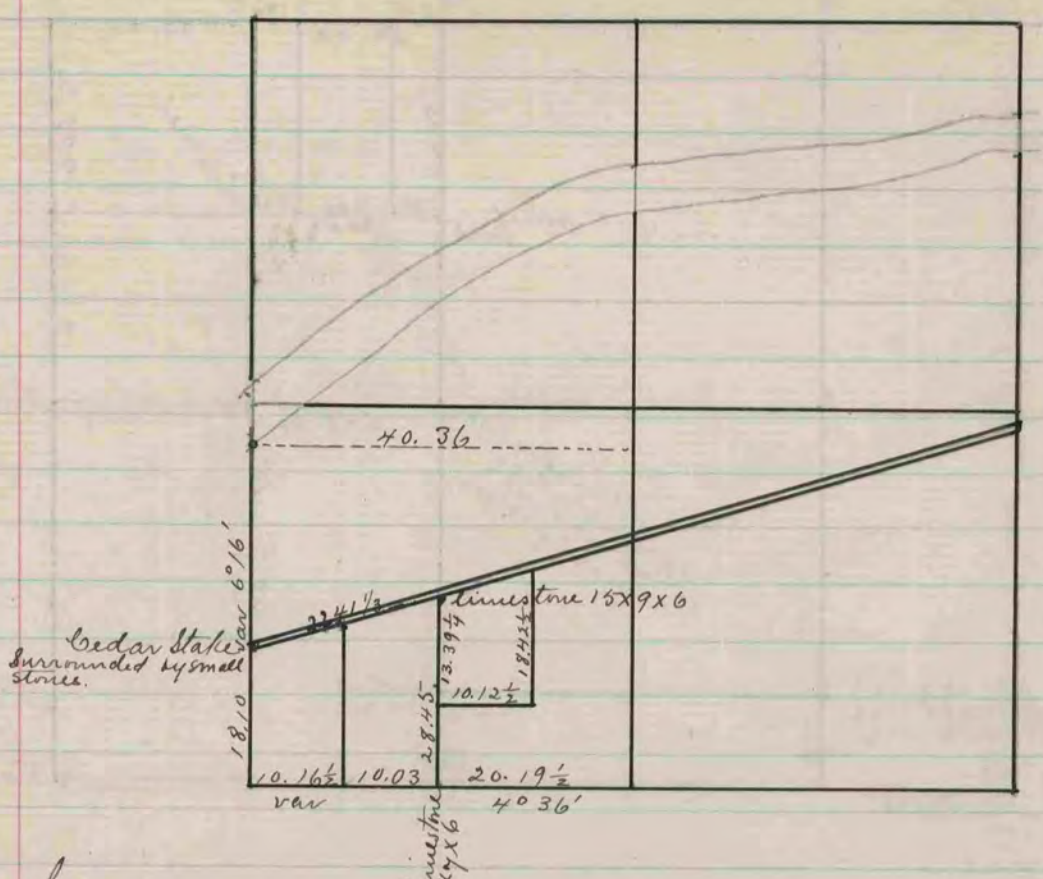

The above is a record plat of a survey made on Sec. 2 Rock - May 8 1871 by Edward Ruger County Surveyor.

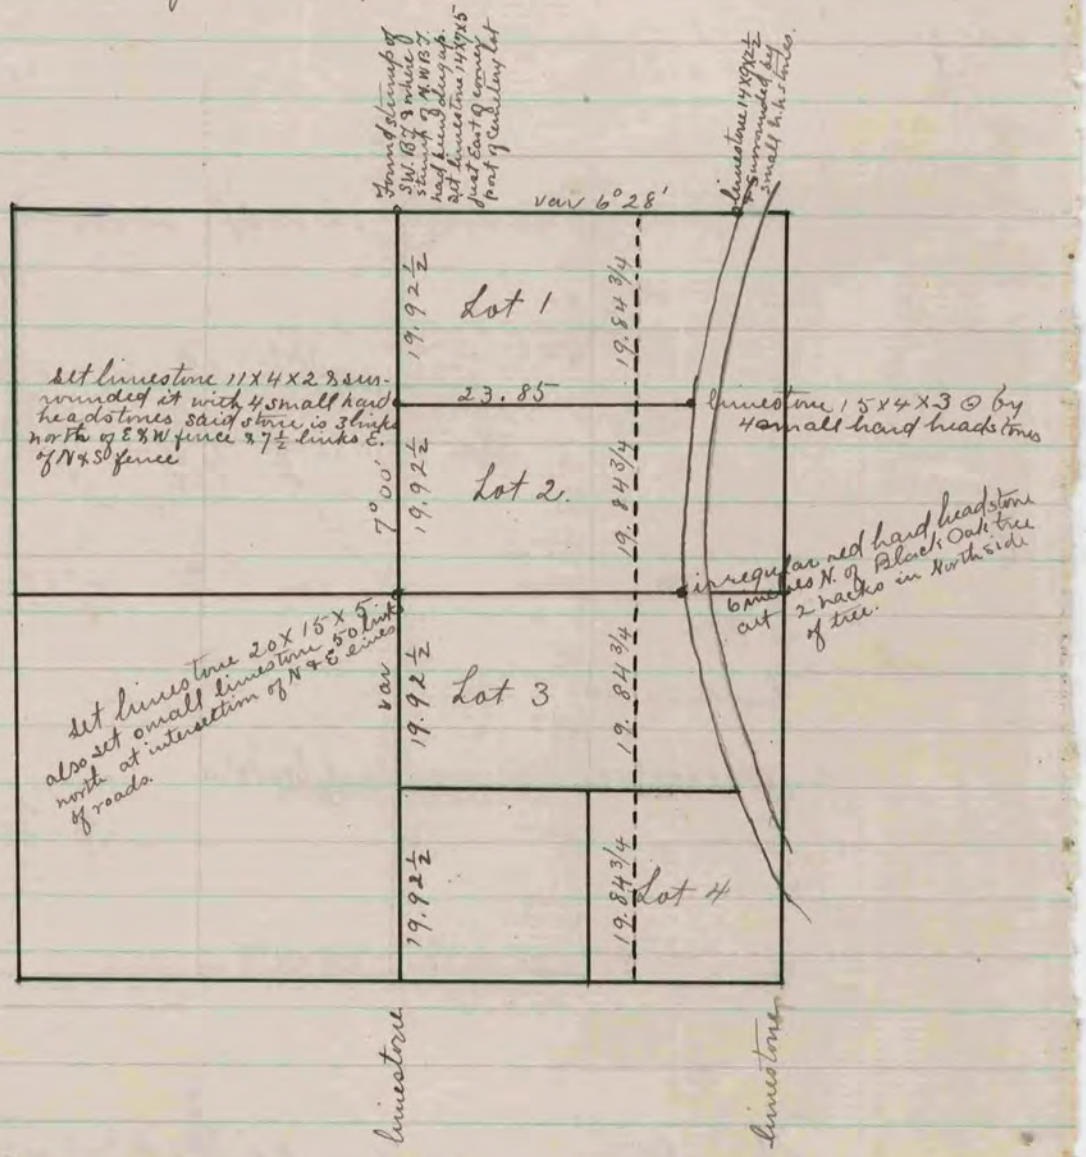

The above is a record & plat of a survey made on Sec. 26 Janesville, Apl. 26 & 27-1871 by

Edward Ruger
Co. Surveyor.