COUNTY SURVEYOR
RECORD 1859-1906

Below is a record & plat of a Survey made by me - April 28-1880 on Sec. 11 Rock - S. C. Woods self chainmen -

R. K. Lee, Dept C. Surveyor -

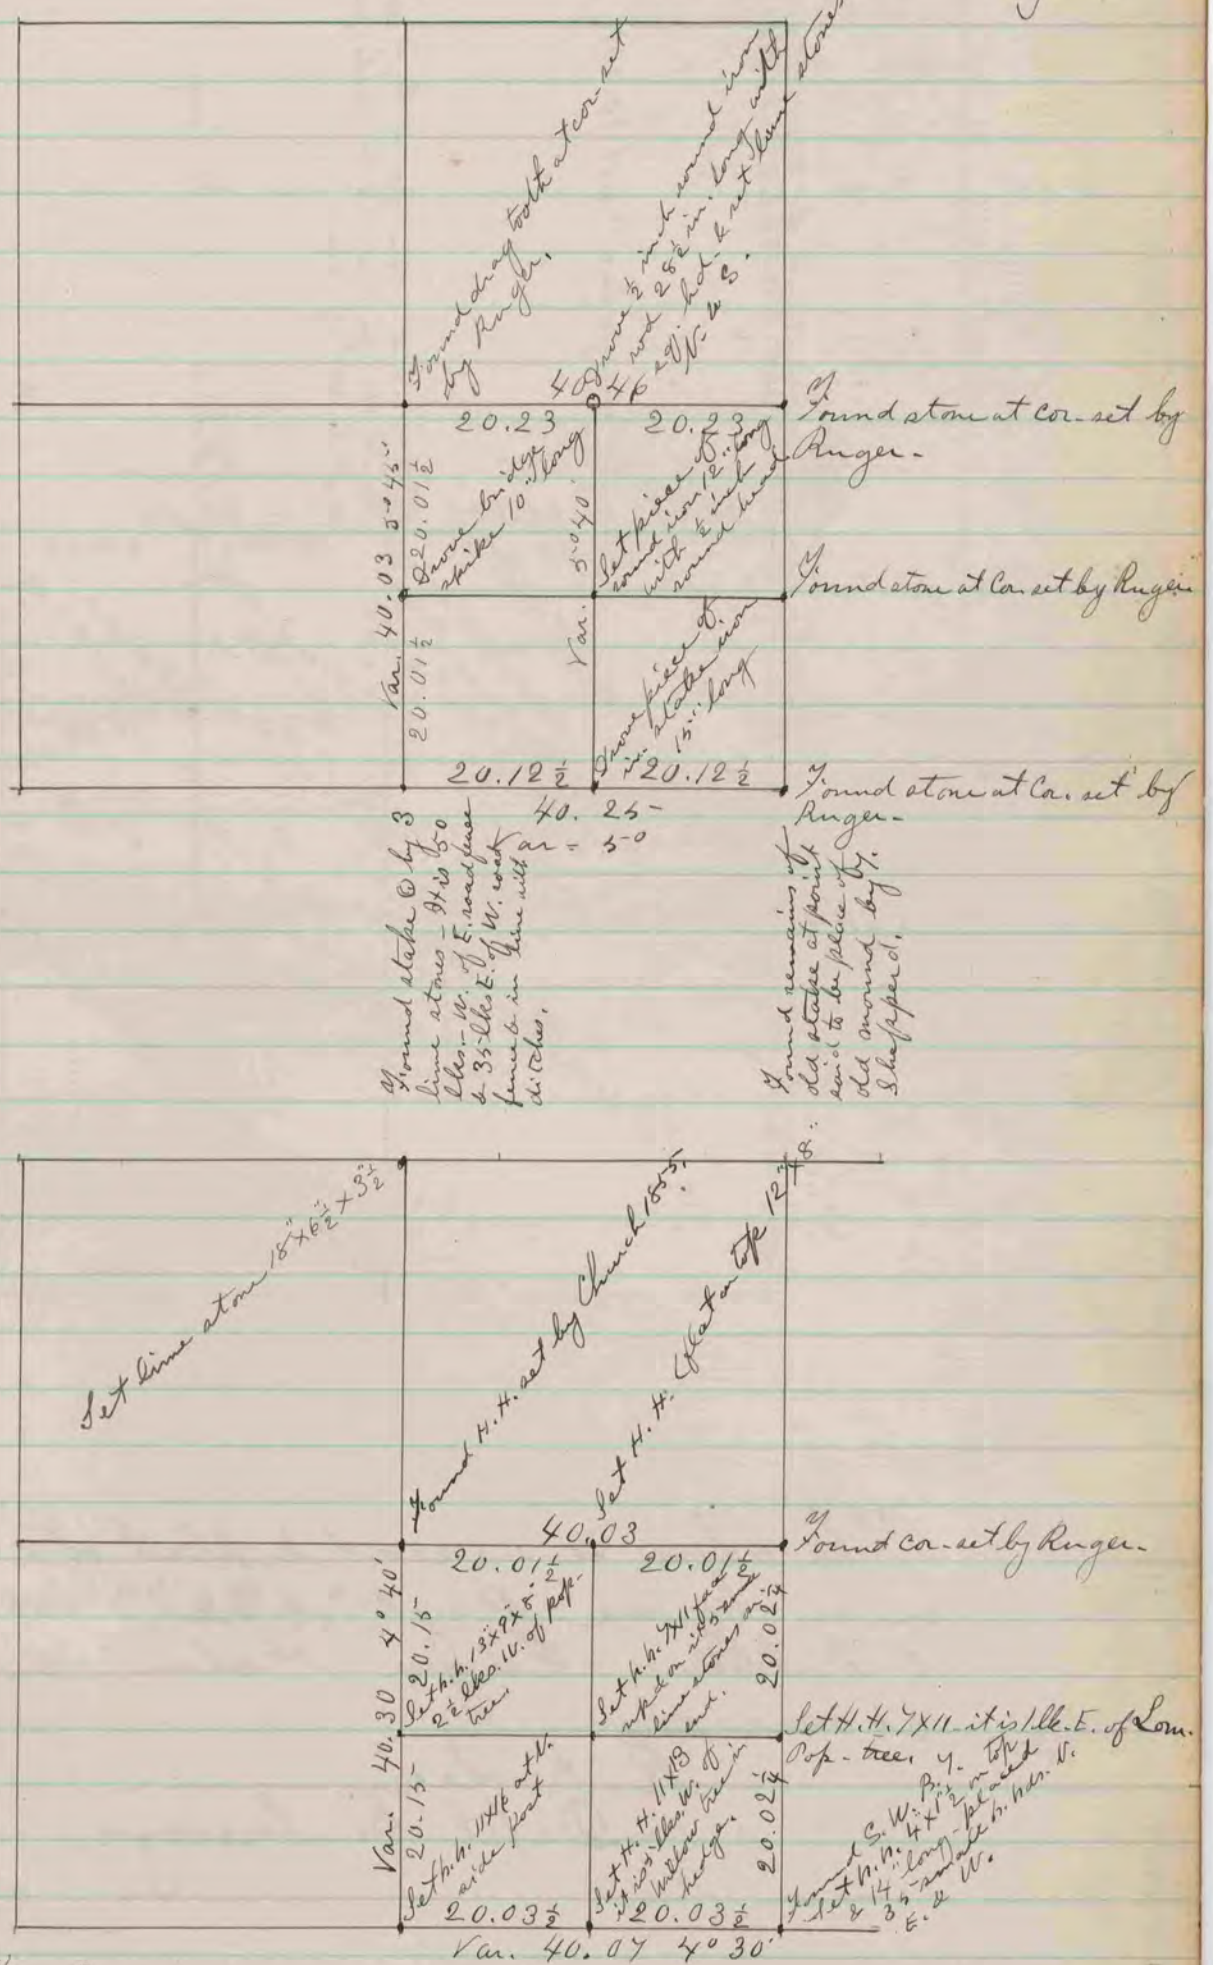

The above is a record & plat of a Survey made by one May 3 1880 on Sec. 10. Clinton - S. Lake jr. & self chainmen -

R. K. Lee

Dept. C. Surveyor -