North ½ of Sec. 2 & Sec. 3. Newark

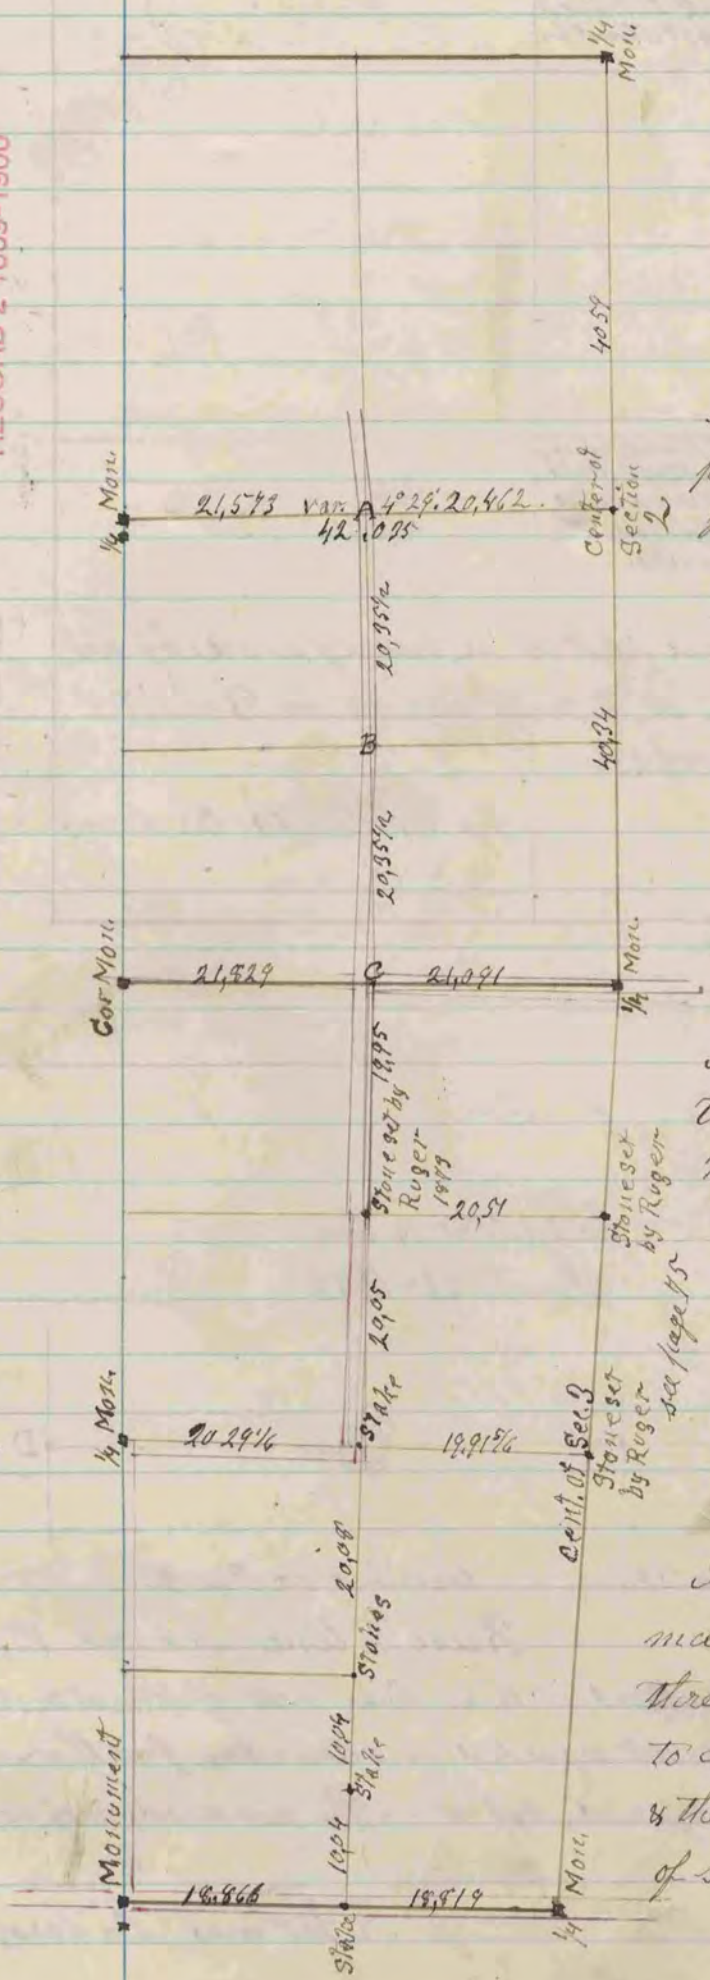

A. Is a notch on top of west bridge plank stake about 1 ft. west

Hickory, 10 S. 66° 45' E 79½

" 6 N 84° 45' W. 15¾

C. Drove part of a Harrow tooth set on top L. S. 15 x 8½ x 4. and is 21 South from line of South fence of road west

Elm in front of house N. 44° 50' W 1,40

Mag. courses.

B. C. S. 1° W 2,89

A. Record and plat of a survey made by me, on Sections two and three in Newark. Feb. 7 & 8. 1882. to determine the location of the road & the South line of the North ½ of N.W.¼ of sec. 3.

J. A. Holmes

County Surveyor

COUNTY SURVEYOR
RECORD 2 1869-1900