COUNTY SURVEYOR
RECORD 2 1869-1900

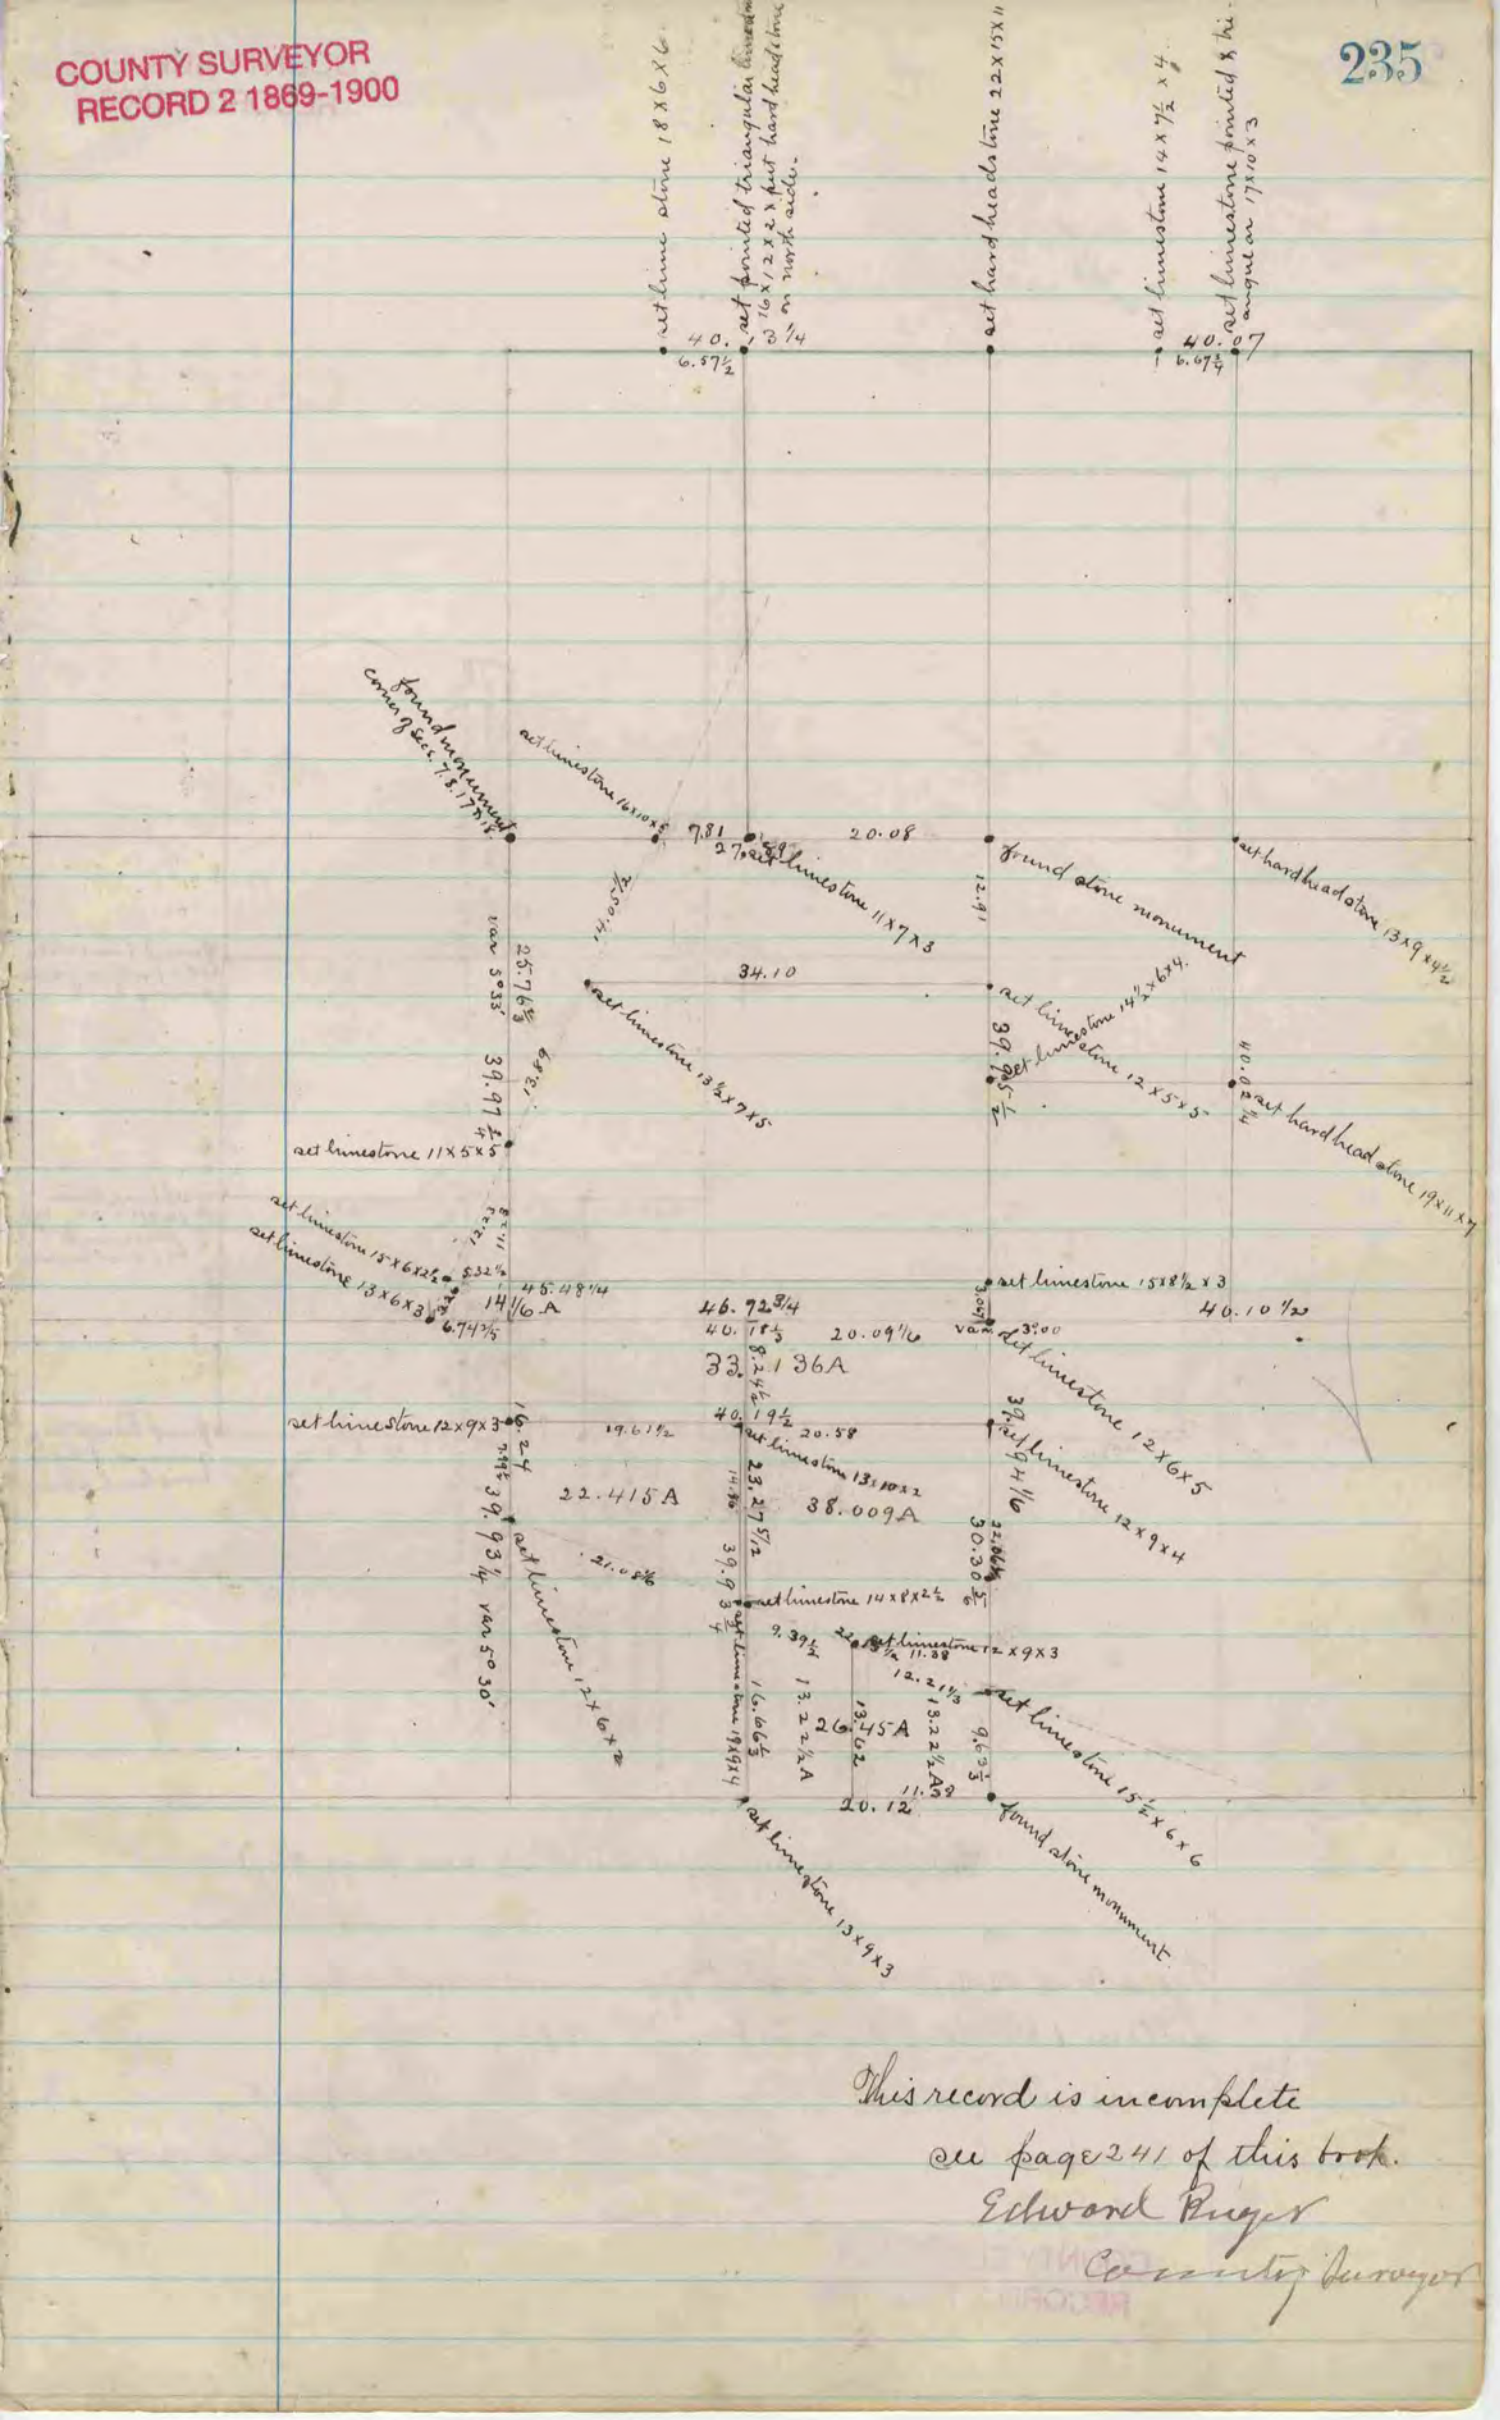

This record is incomplete
on page 241 of this book.
Edward Bruyer
County Surveyor