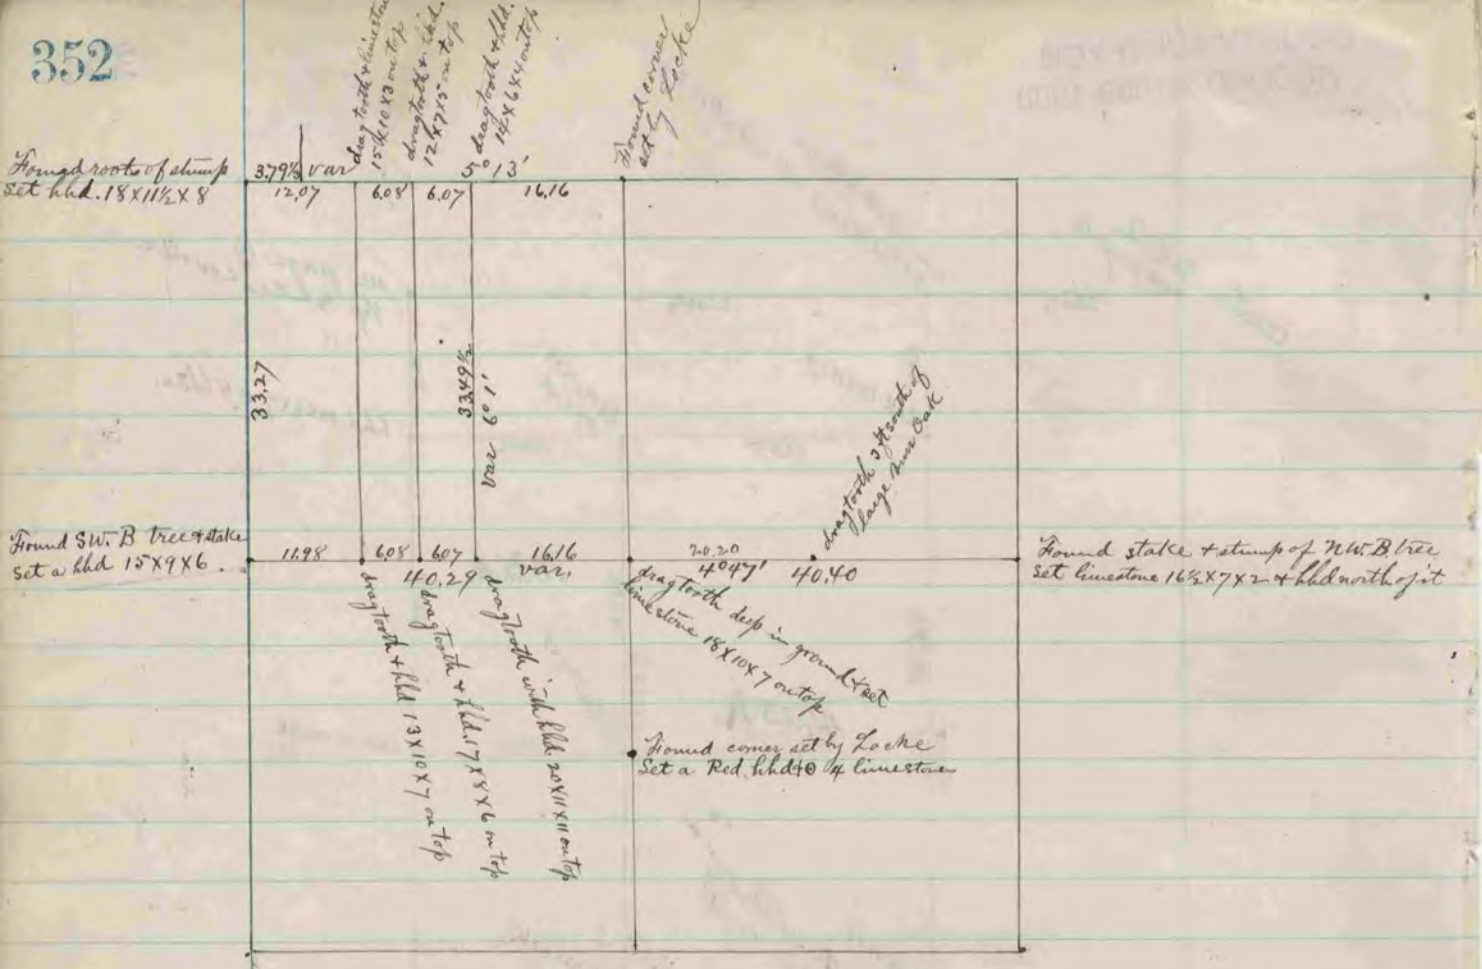

The above is a plat + record of a survey made by me on Section 5 Magnolia, Oct. 23 + 24, 1890

O. F. Bleedorn Dept. County Surveyor

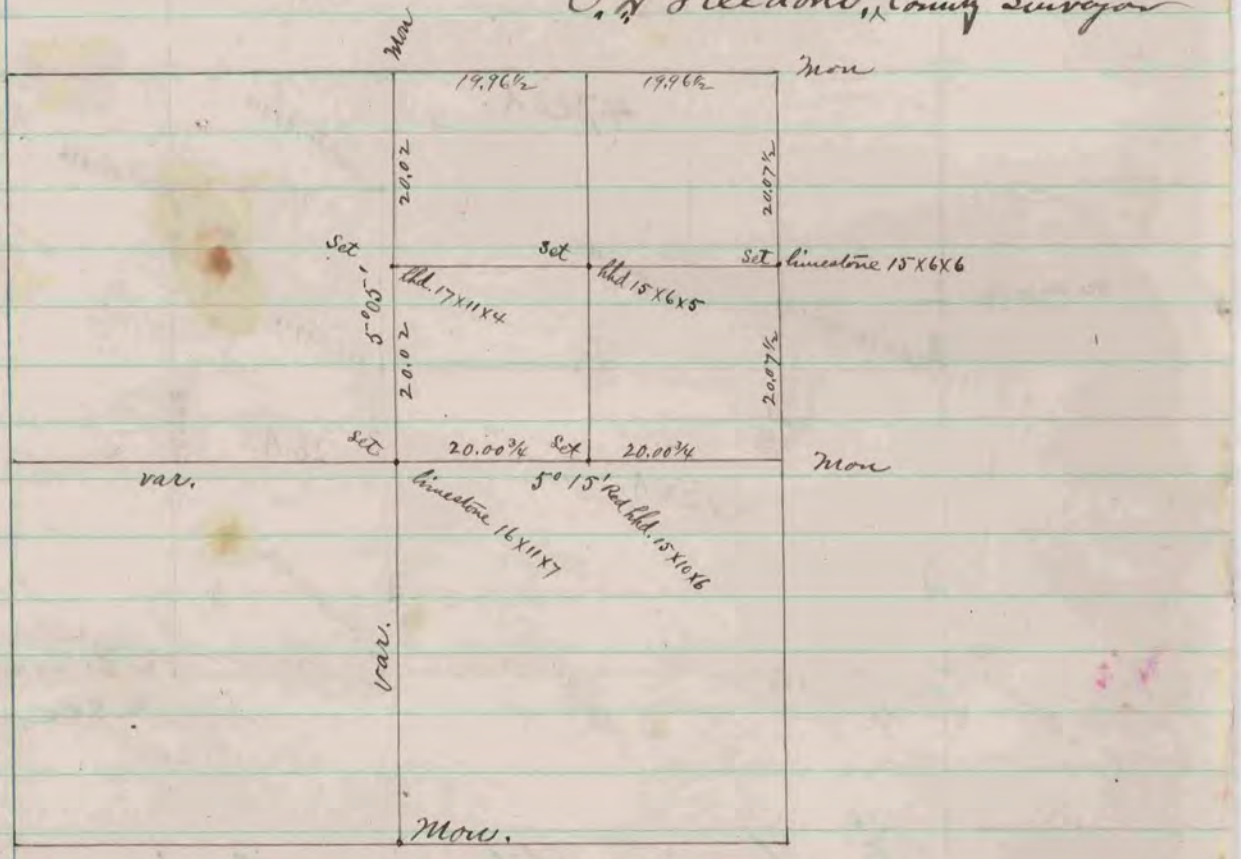

The above is a plat + record of a survey made by me on Section 31 Union Oct 24 + 25, 1890

O. F. Bleedorn
Dept. County Surveyor