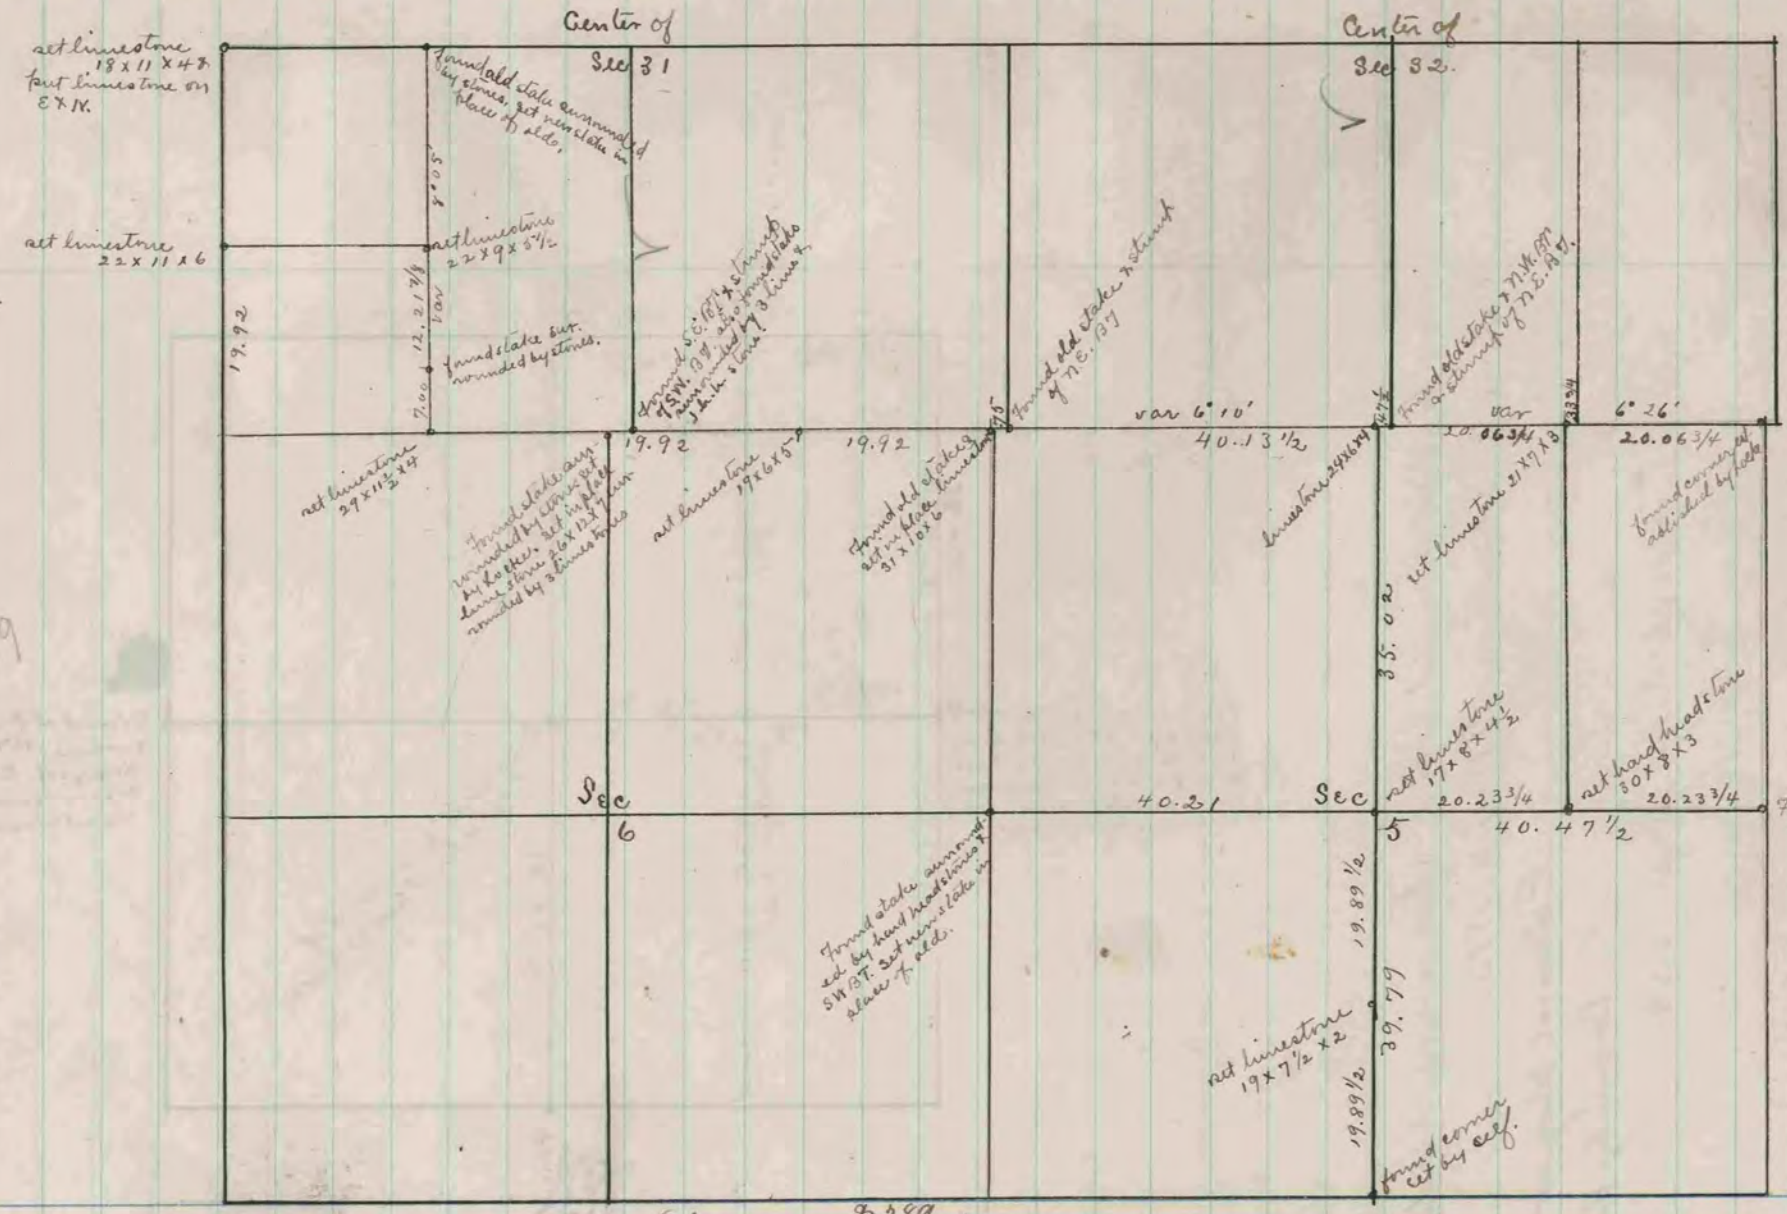

(See pages 329 & 289 of this book & page 257 of Book I.)

The above is a record & plat of a survey made by me on Sections 5 & 6 Spring Valley & 31 & 32 Magnolia, December 19-21-1882.

Edward Rieger
County Surveyor.

K-19

332