COUNTY SURVEYOR
RECORD 2 1869-1900

Found old stake in center of Creek - the stake is driven ... feet - surrounded stake with 4 line stones

Found stumps of B.T.s. Drove new stake

set sand stone 15 x 8 x 3

Found old stake & stumps of N.E. & S.W. B.T. stump of N.W. B.T. dug up - Drove new stake in place of old one and surrounded it with 4 hard head stones

Found old stake - Drove new stake deep in place of old one & put one top of it lime stone 11 x 7 x 3 it is 18 links north of E & W fence & 21 links west of N. & S. fence

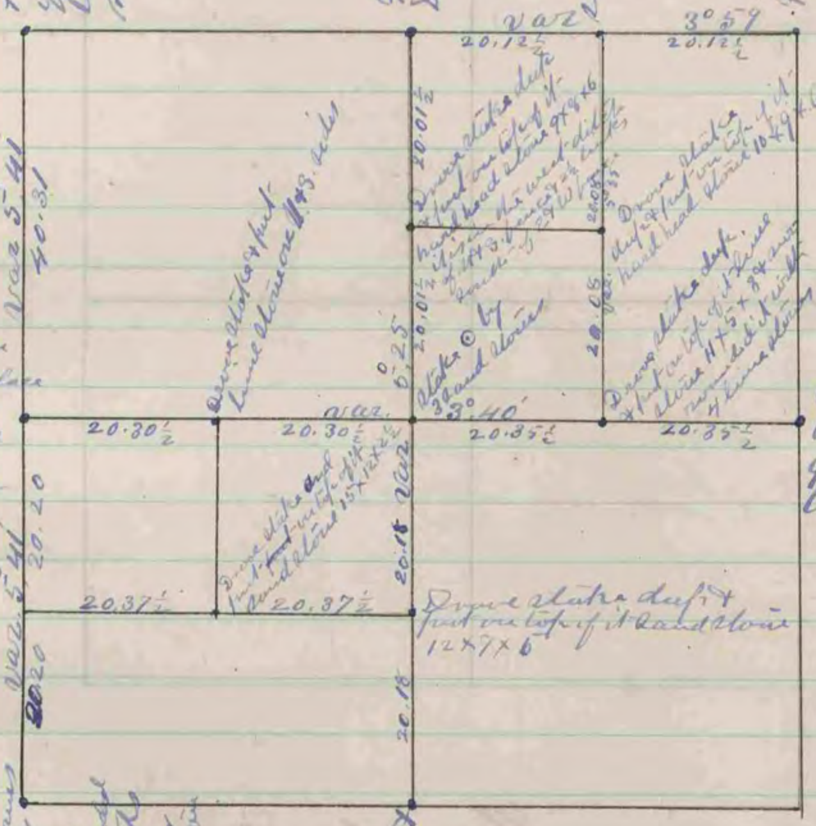

Corner established by self. See section 9 Page 40 of this book

Found old stake in remains of a mound - Drove large burnt oak stake in the place of the old one and surrounded it with 3 lime stones, the top of the lime stones are near the surface of the ground where the stake is

Found lime stone at Corner

The above is a plat and record of a survey made by me on section 8 Avon June 23 & 24 - 1874

Edward Ruger
County Surveyor