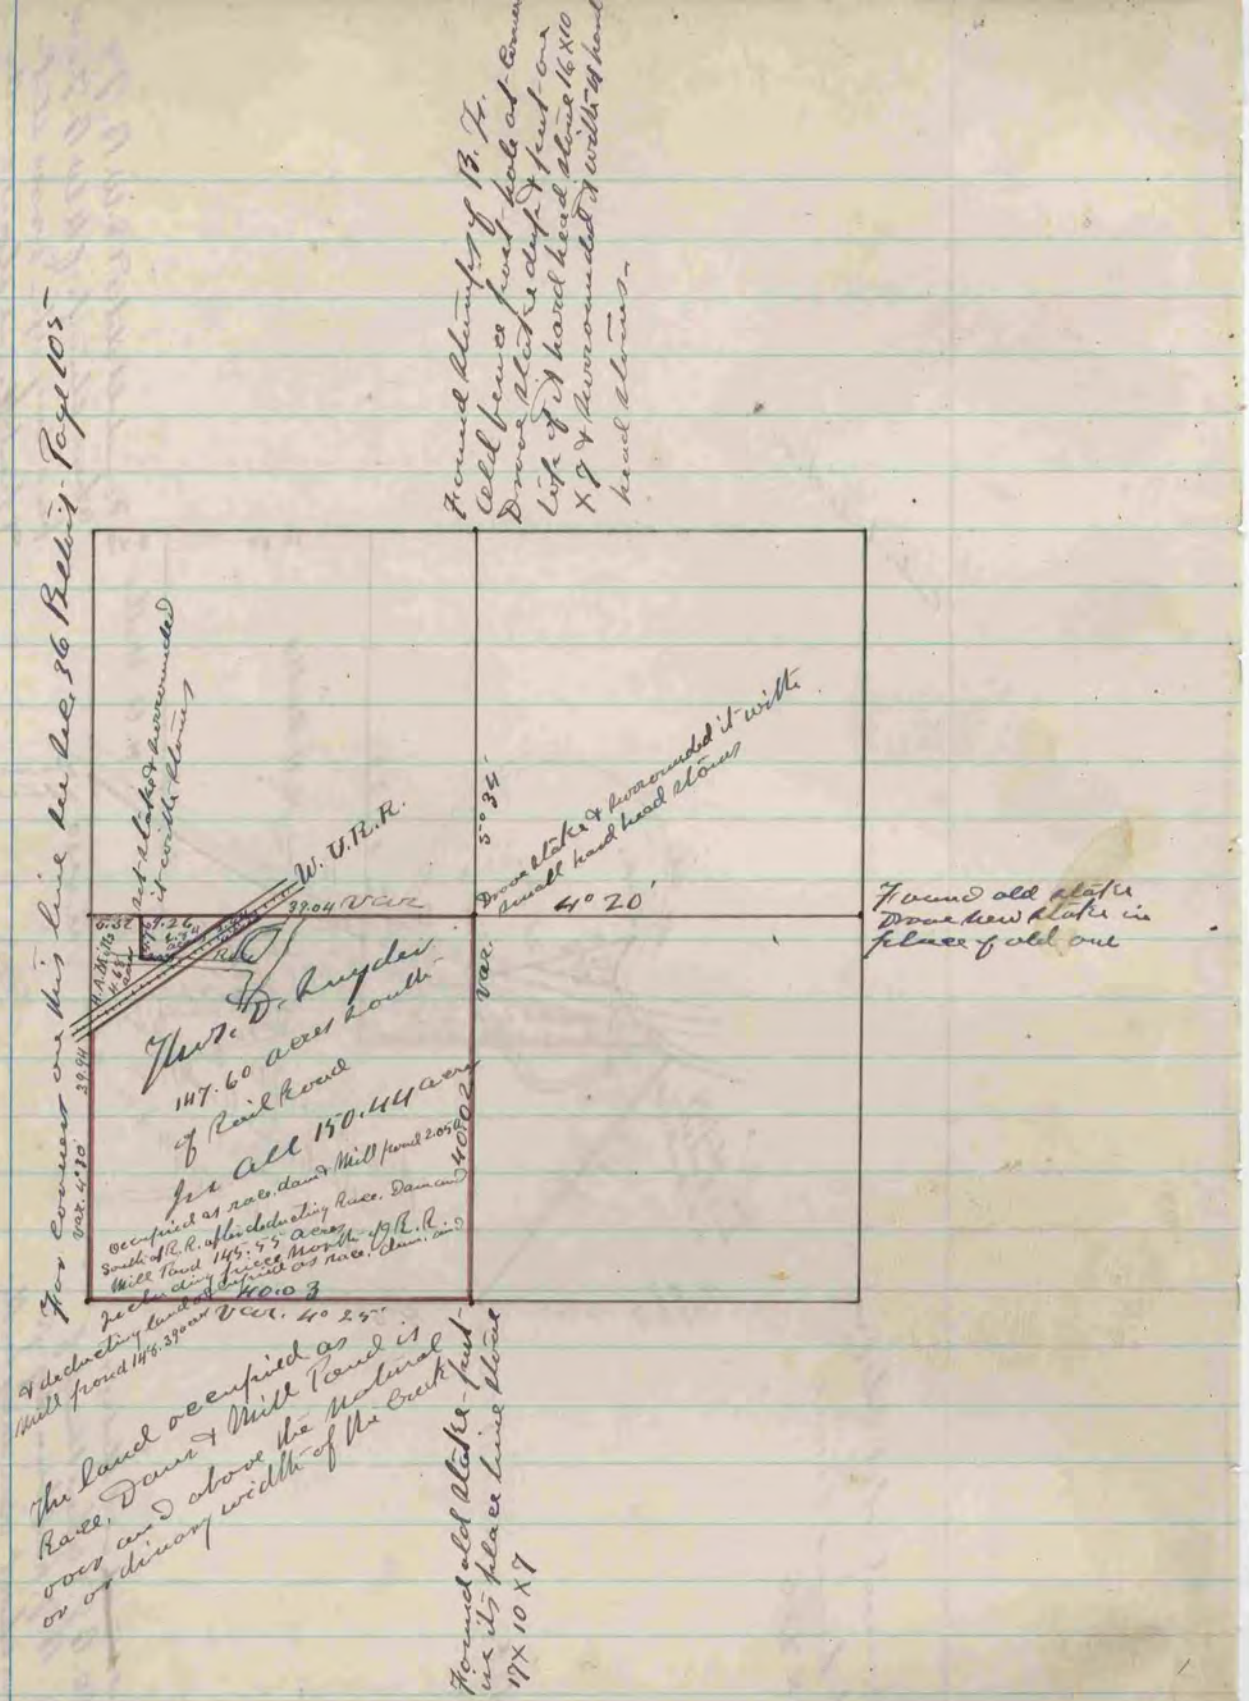

The above is a record and plat of a survey made by me on Dec. 31 & July 23-28 1874

Edward Ruyder
County Surveyor

COUNTY SURVEYOR
RECORD 2 1869-1900