Paper weight [redacted] minimum) [redacted] Black non-fading ink [redacted] required

U.S. PUBLIC LAND SURVEY MONUMENT RECORD

For Public Land Survey Corners in:

T. 1 N., R. 12 E

WI ADMINISTRATIVE CODE A-E 7.08 REQUIREMENT

CORNER CODE INDEX

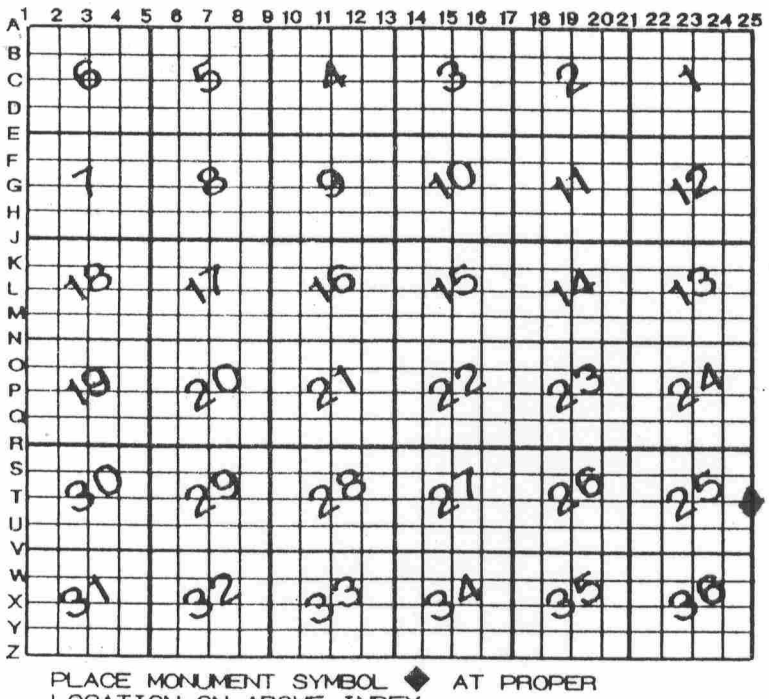

PLACE MONUMENT SYMBOL ◆ AT PROPER LOCATION ON ABOVE INDEX

BELOIT TWP

ROCK COUNTY WI

IF AVAILABLE
ROCK COUNTY COORDINATES PERFERRED

North 190,270.64 Elev. _____

East 2,226,437.94 6008

Hor. Datum NAD83 27 Vert. Datum _____

LATITUDE _____ ELLIPS. HT.

LONGITUTE _____ _____

GPS (X) ___ TRAVERSE (X) ___

BASED ON THE FOLLOWING CONTROL:

◆ CORNER MONUMENT ALUM

○ WITNESS MONUMENT

(a)

WIDOT 5989-02-46
DATE: 10/20/89

BEARINGS ARE BASED ON: _____

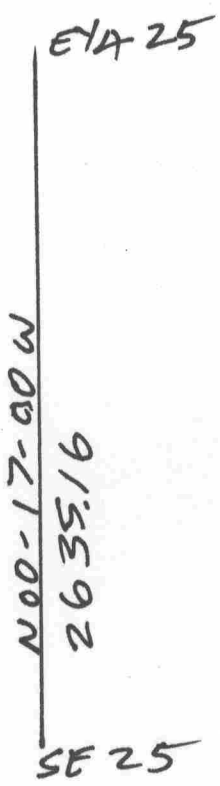

Donald Bauer
4-04-04

FIELD BOOK _____ PAGE # _____ SHEET 1 OF 1

SHOW A PLAN VIEW DRAWING DEPICTING THE CORNER MONUMENT AND SURROUNDING PHYSICAL FEATURES, INCLUDING THE EXCAVATION AREA AND DEPTH.

PLANNING & ZONING COMMITTEE ADOPTED THE ABOVE FORM ON 12/2/1982

CORNER CODE T-25 (1)