

PUBLIC LAND SURVEY MONUMENT RECORD

For Public Land Survey Corners in the


T. 1 N., R. 13 E

CORNER CODE INDEX

	1	2	3	4	5	6	7	8	9	10	11	12	13	14	15	16	17	18	19	20	21	22	23	24	25
A																									

PLACE MONUMENT SYMBOL (◆) AT PROPER LOCATION ON ABOVE INDEX

EXAMPLE

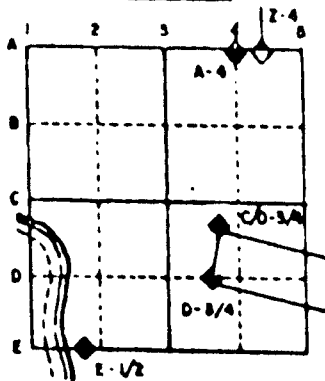

TURTLE TWP
ROCK COUNTY WI

IF AVAILABLE
STATE PLANE COORDINATES

North (Y) _____ Eleve. (Z) _____
 East (X) _____ Zone _____
 Hor. Datum _____ Vert. Datum _____

◆ CORNER MONUMENT

○ WITNESS MONUMENT

BEARINGS ARE BASED ON:

SHEET 1 OF 2

CORNER CODE: L 25

(B) Describe any record evidence, monument evidence, occupational evidence, testimonial evidence or any other material evidence you considered, and whether the monument was found or placed.

1859 RUGER VOL 1 PG 94 TOOK NEW WITNESS TREES. BUR OAK 8 S51-35E 170, BUR OAK 8 N68-28W 170. 2649.24 TO SW COR SEC 18.

1914 COLDWELL VOL 3 PG 73 FOUND STONE 2660 TO SW COR SEC 13, 2648 TO CENTER OF SEC 13, & 5296 TO E 1/4 COR SEC 13.

1959 BATTERMAN VOL 4 PG 28 SET 1" PIPE ON EAST SIDE OF STONE FOUND 4X4X6 POINTED LIMESTONE. 2646.65 TO NW COR SEC 18.

1980 BARNES VOL 6 PG 81 2666.01 TO SE COR SEC 13, 2646.75 TO NE COR SEC 13.

1980 BARNES VOL 6 PG 80 FOUND 1" PIPE. REPLACED IT WITH ALUM. MON. 2' SOUTH OF E/W FENCE ON LINE WITH N/S FENCE.

FOUND ALUM. MON.

C) Was the corner restored through acceptance of (1) an obliterated evidence location, or, (2) a found perpetuated location?

ACCEPTED FOUND PERPETUATED LOCATION.

D) Describe any material discrepancy between the location of the corner as restored or reestablished and the location of that corner as previously restored or reestablished by distance and direction. Show the discrepancy on the plan view drawing under (a), above. Show the distances between the corner as previously restored or reestablished and (1) the corner as restored or reestablished, and (2) to at least 4 of the witness monuments shown on the drawing in (a), above.

(E) Was the corner reestablished through lost corner proportionate methods? If so, show the method, including the directions and distances to other public land survey corners used as evidence or used for proportioning the corner location.

NO

I, Donald Barnes, hereby certify that the corner points as identified by the corner code index were, in a field survey on, 1994, established, re-established, monumented, re-monumented, recovered or restored as expressed below and in conformance with the regulations and rules as required in the current manual of survey instructions of the United States Department of Interior, Bureau of Land Management.

seal

Donald Barnes
096, 1995

EMBOSS LAND SURVEYOR SEAL

COUNTY SURVEYOR FILING DATA

Date of computer entry _____


Date microfilmed _____

Number of included sheets _____

CORNER CODE

A-E 7.08 REQUIREMENT

225

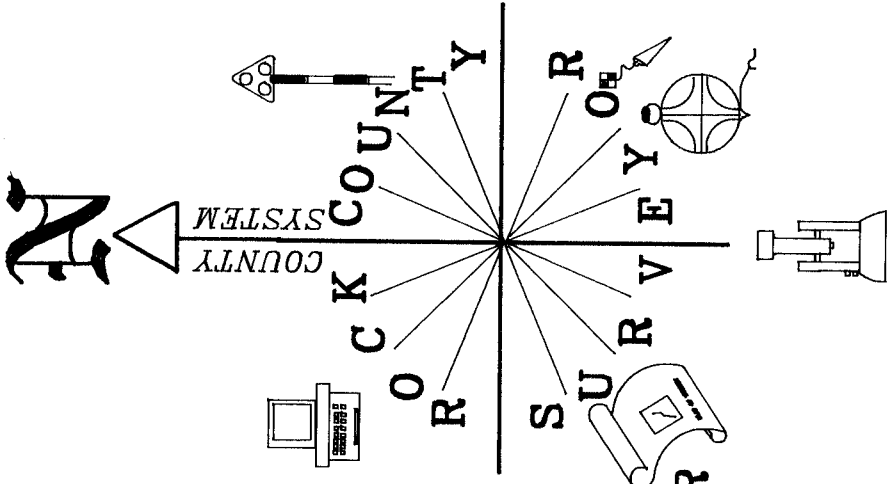

**N 1/4 COR
SEC 13**

**NE COR
SEC 13**

**E 1/4 COR
SEC 13**

**S 1/4 COR
SEC 13**

SE COR SEC 13

S86-40-27E 2647.16

S0-14-59W 2646.77

S0-0-07W 2665.99

S42-12-59E 3842.50

FD ALUM.
MON.

N46-01-43E 3700.32

N87-55-01E 2664.73

S0-20-26W 5369.54

125

*Donald Ferras
OCT 6, 1995*