300

PLAT AND RECORD

Of a Survey on Section 1 T 4 R 12 E. of the 4 P. M. in Fulton Township

Rock County, Wisconsin, made May the 5, 6 & 7 1880

I hereby certify that the following is a correct record of said survey as made by me.

COUNTY BUILDING
IN CITY OF BELOIT

(Signed) R. K. Lee
R&B

Dep't. County Surveyor.

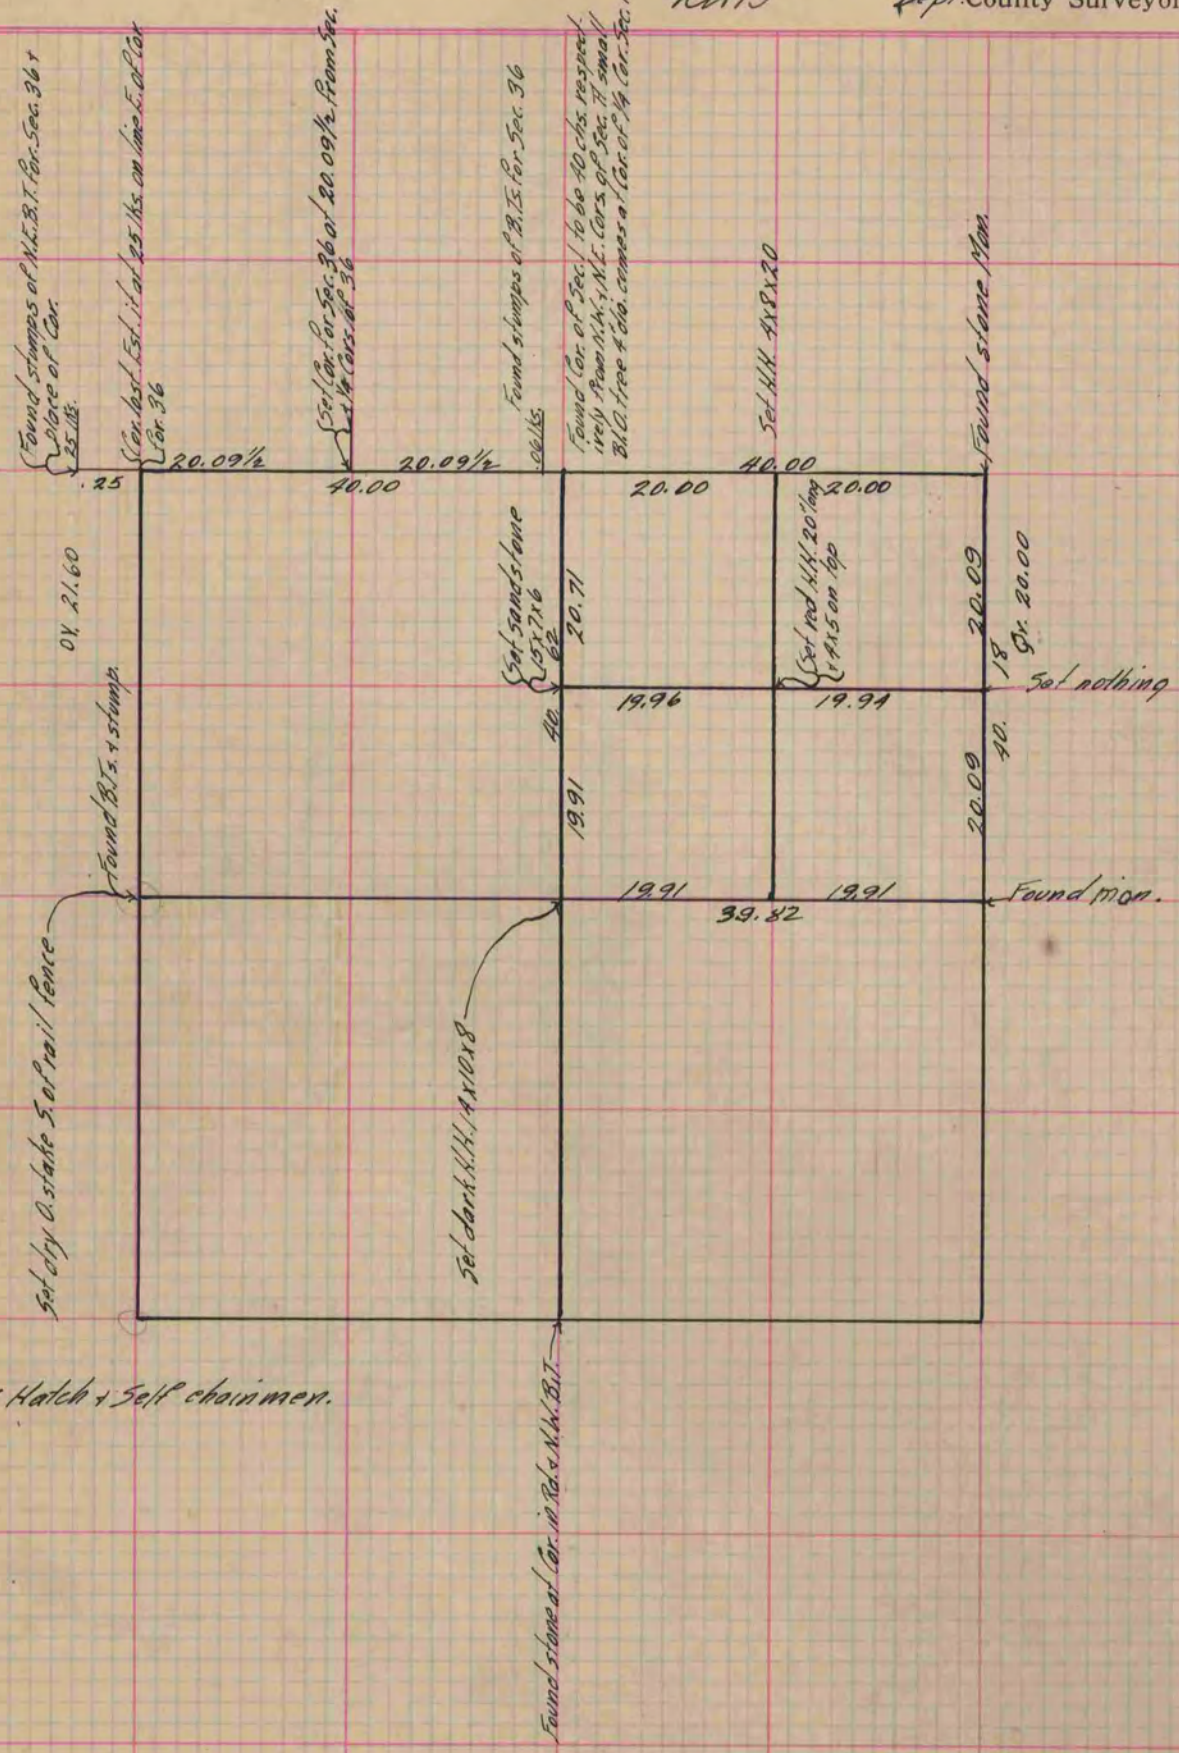

Edgar Hatch + Self chainmen.

Copied from P. 251 Vol. 2 County Surveyor's Record.