PLAT AND RECORD

Of a Survey on Section 6 T 3 R 13 E. of the 4 P. M. in Harmony Township

Rock County, Wisconsin, made May the 24th 1860

I hereby certify that the following is a correct record of said survey as made by me.

COUNTY BUILDING
IN CITY OF BELOIT

(Signed) Edward Ruger.
County Surveyor.

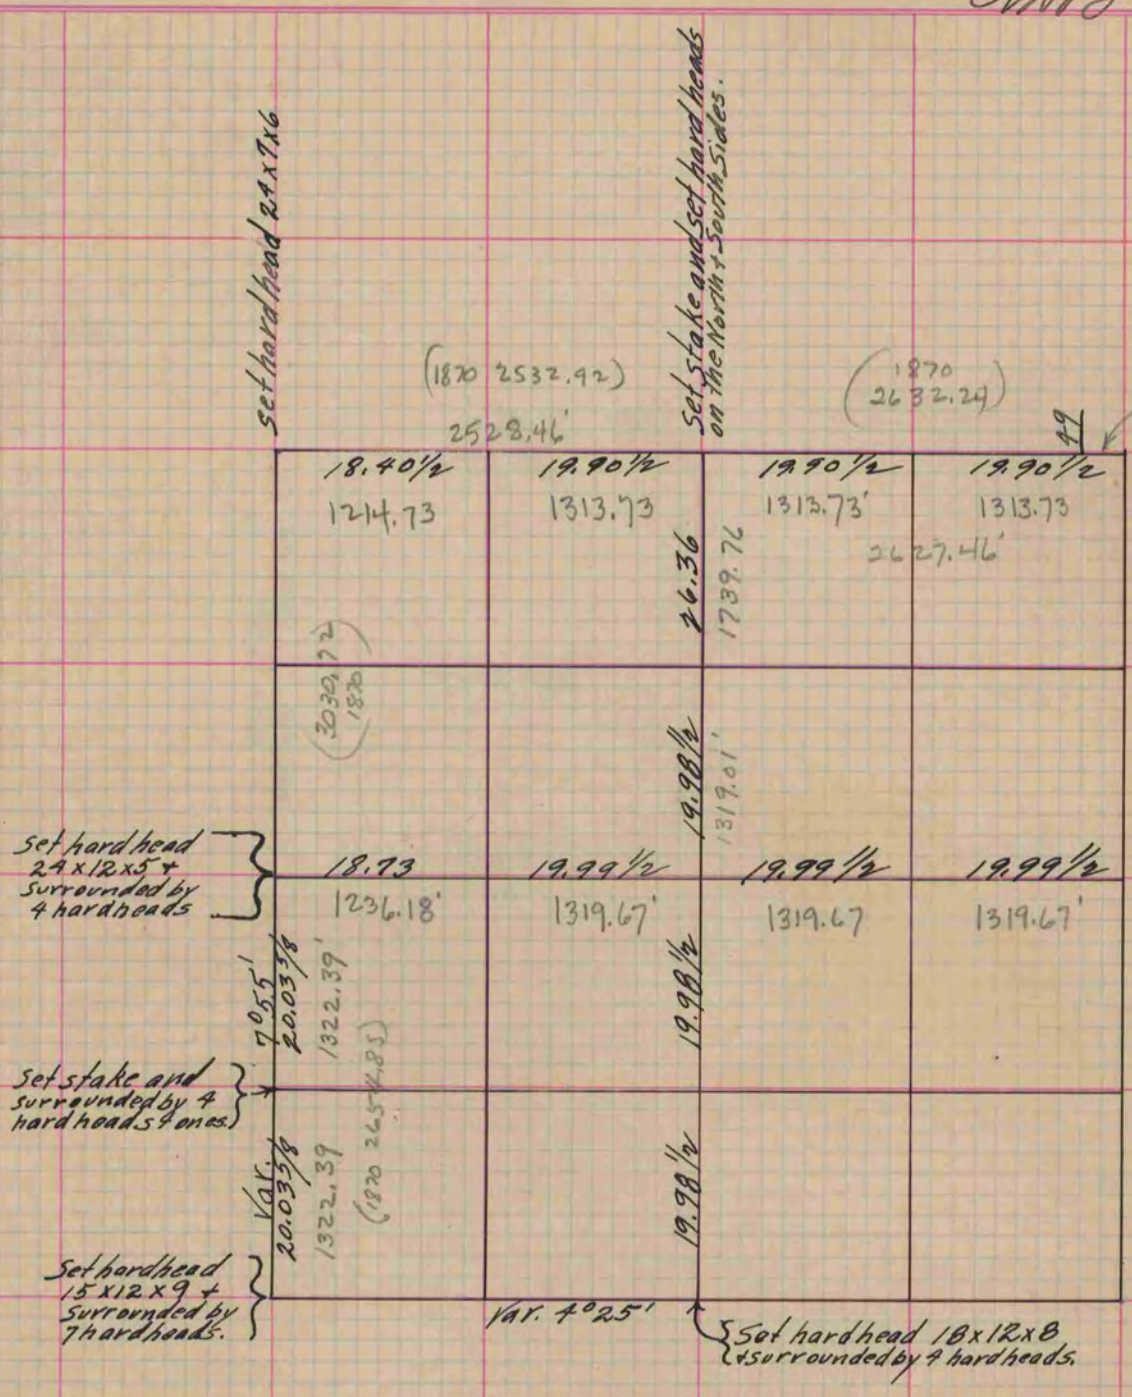

Copied from Page 142 County Surreyors Record.