171

PLAT AND RECORD

PG 189 JANESVILLE
REC 12/12/75 DAB

27. 28, 29, 30
Of a Survey on Section 31, 32, 33, 34 T 1 N. R. 12 E. of the 4 P. M. in Beloit Township

Rock County, Wisconsin, made November the 12 to 16 1932.

I hereby certify that the following is a correct record of said survey as made by me.

B. J. Burney
County Surveyor.
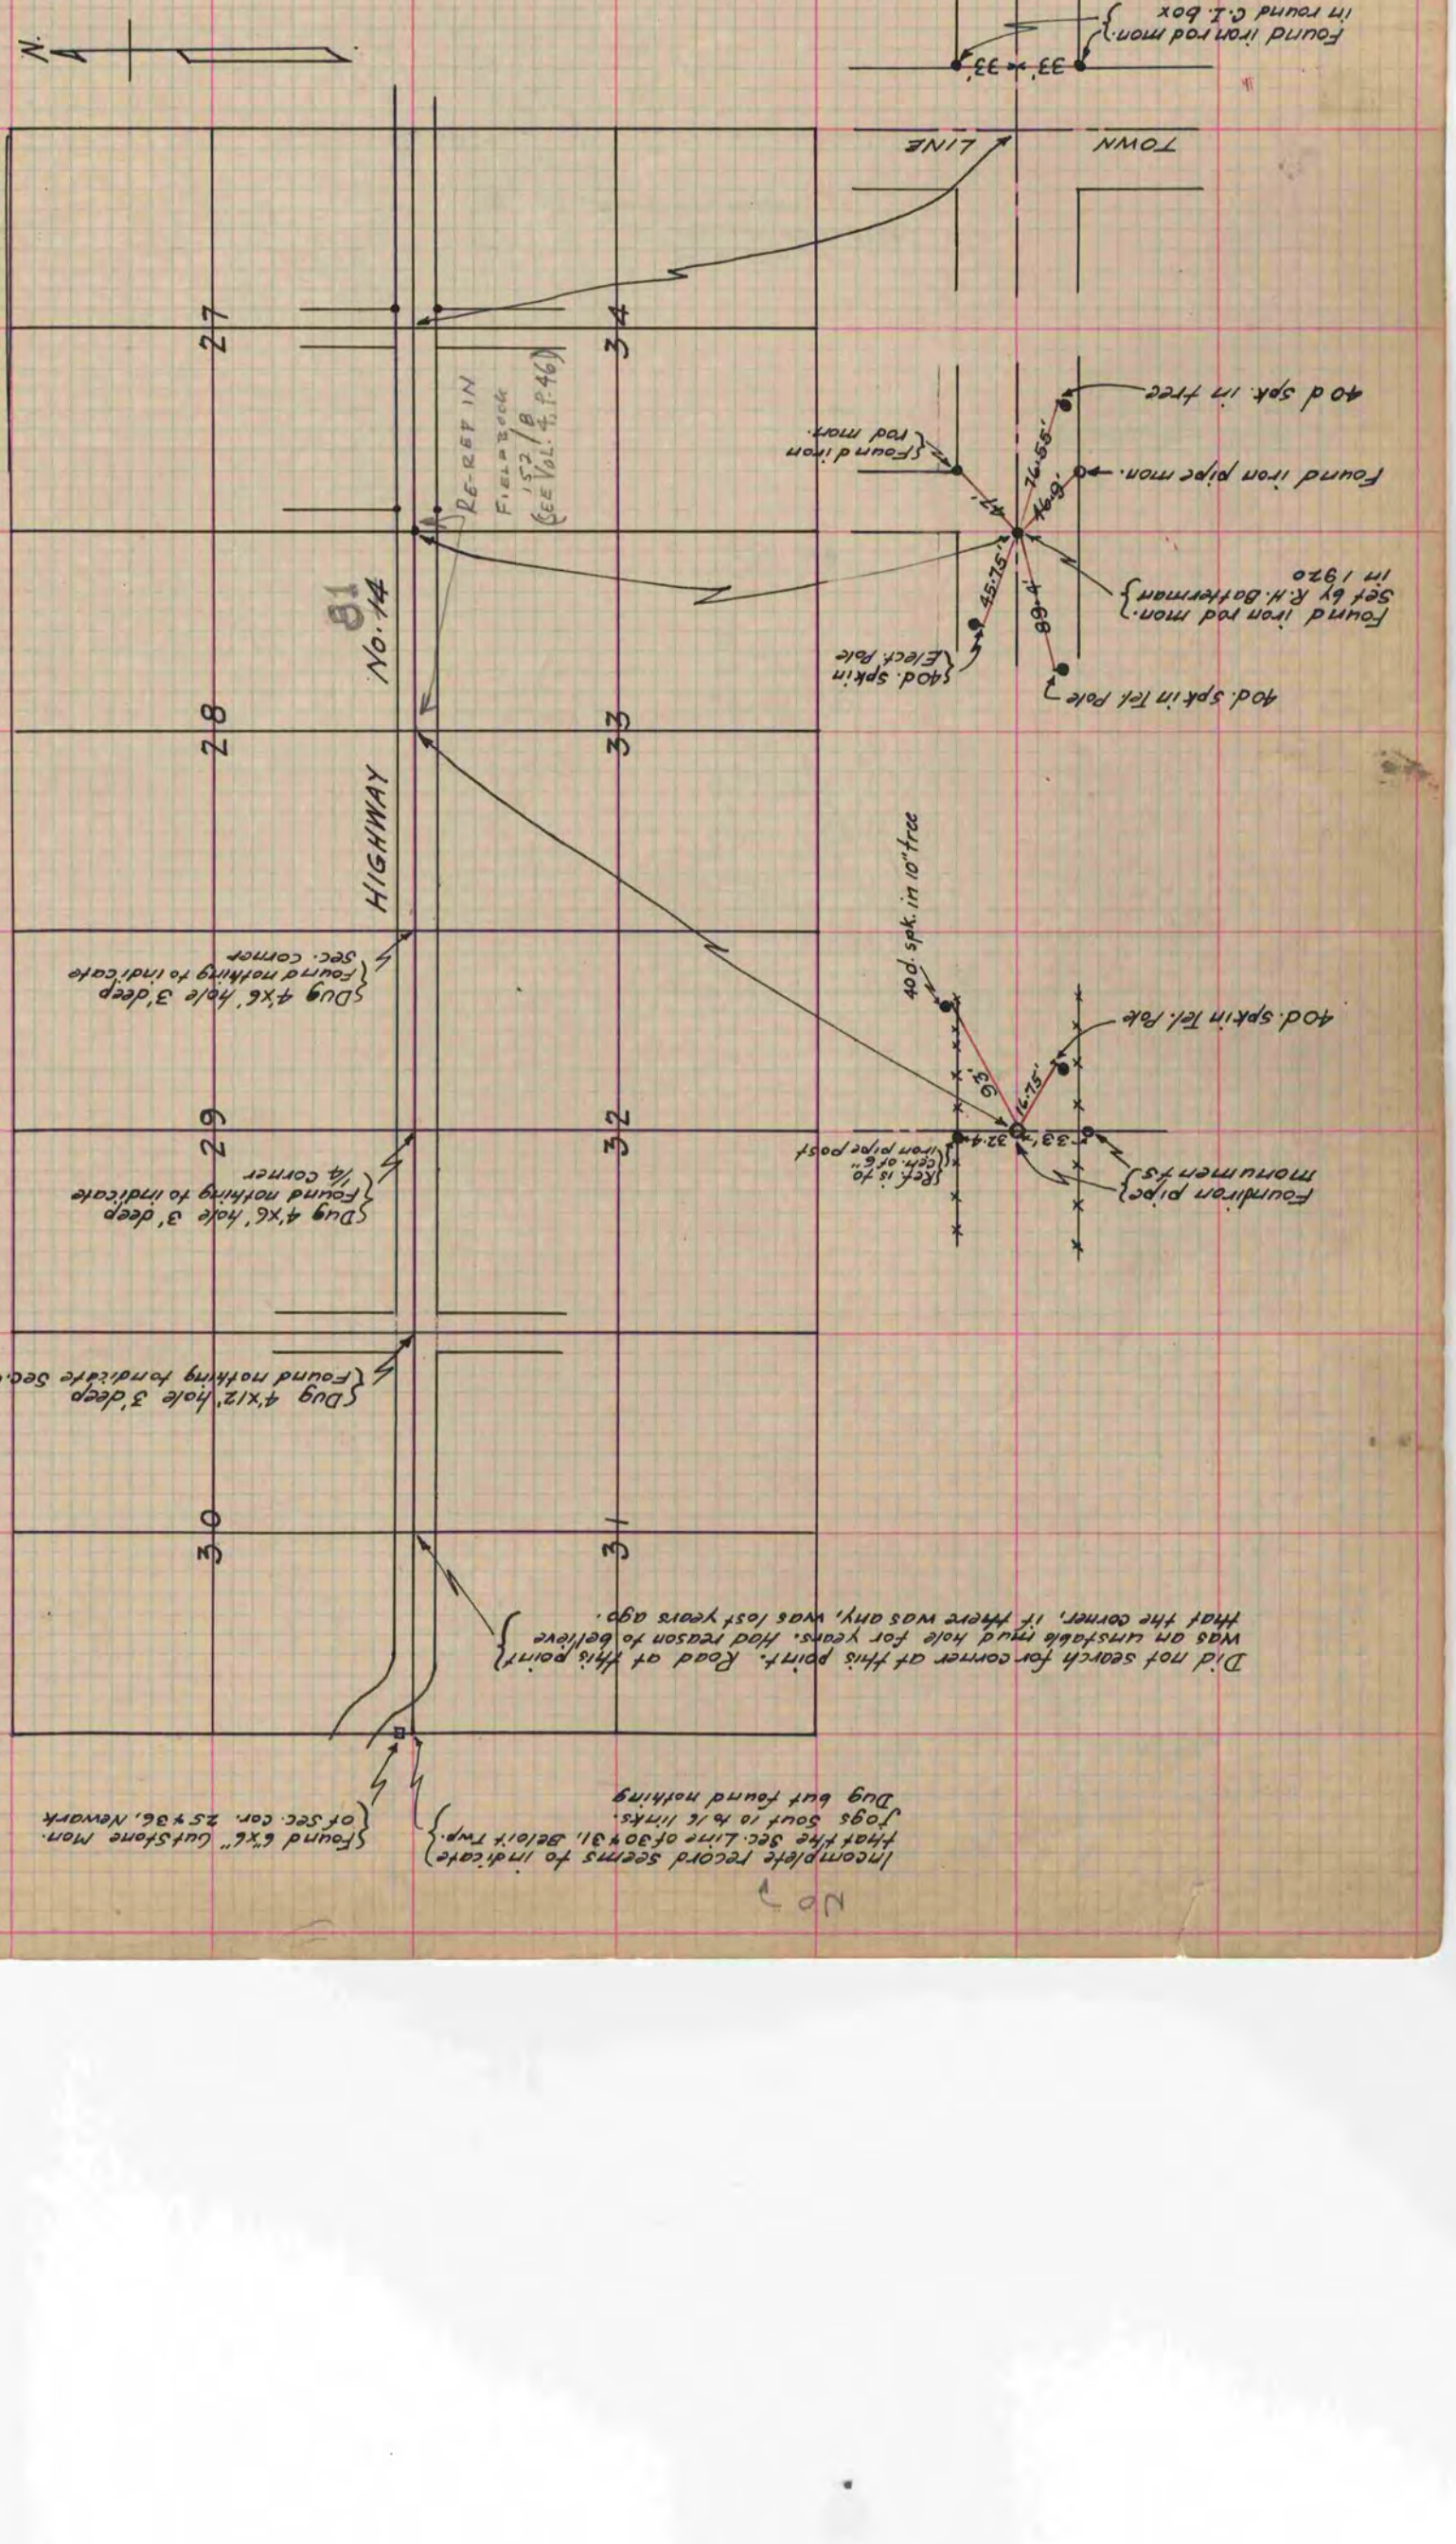
COUNTY BUILDING
IN CITY OF BELOIT