PLAT AND RECORD

Of a Survey on Section 3 T 1 R 11 E. of the 4 P. M. in Newark Township

Rock County, Wisconsin, made December the 4+5 1873

I hereby certify that the following is a correct record of said survey as made by me.

COUNTY BUILDING
IN CITY OF BELOIT

(Signed) Edward Ruger
County Surveyor.

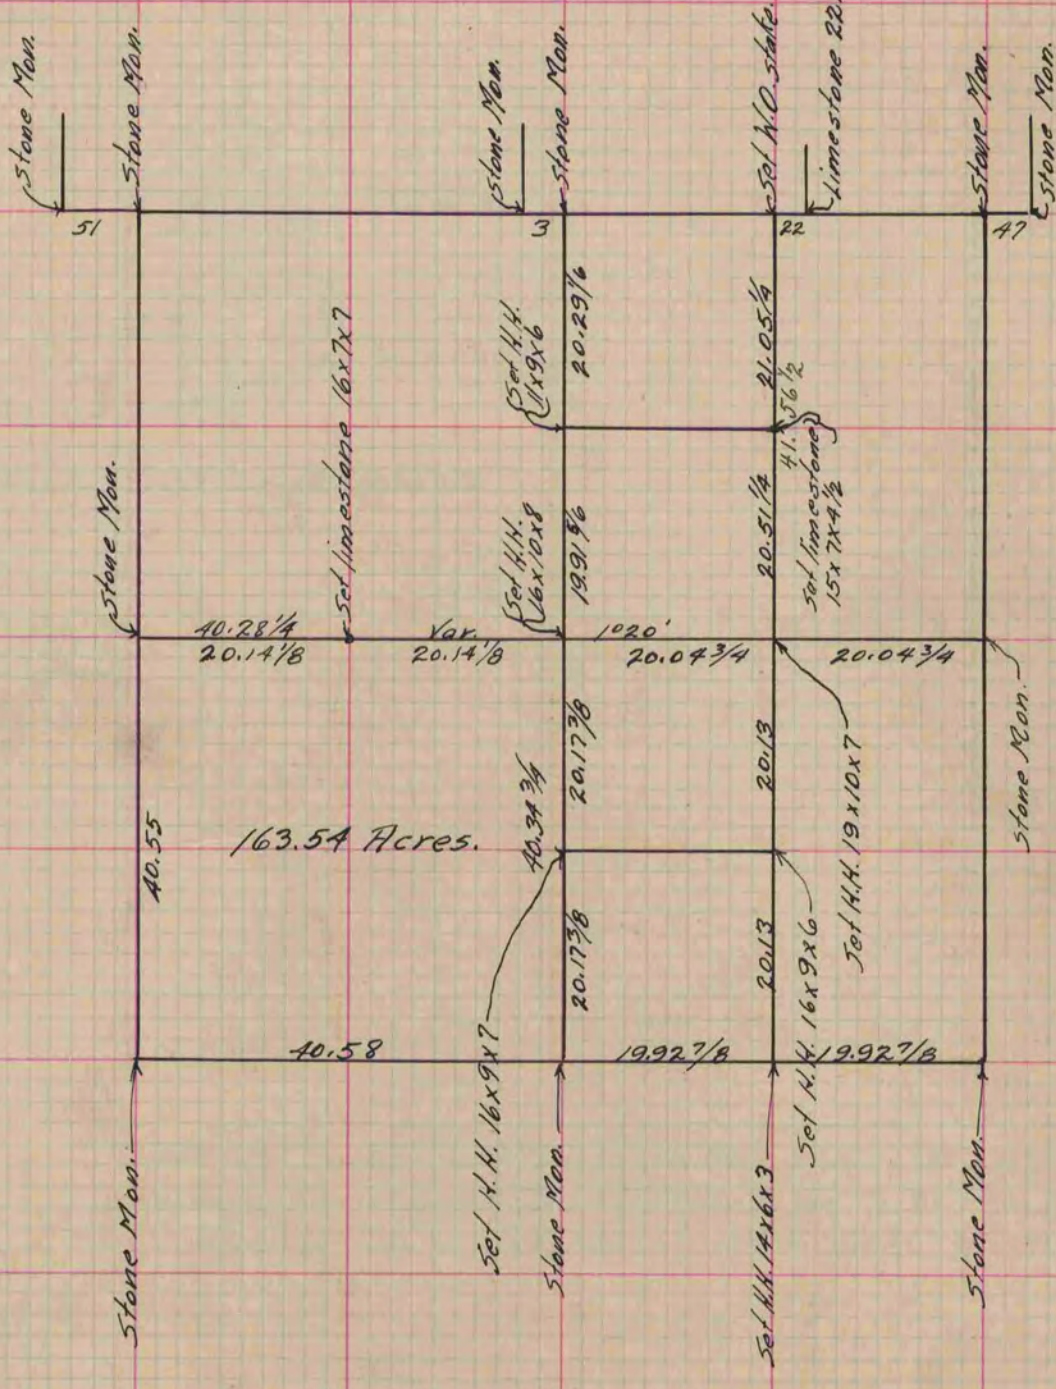

Copied from Page 75 Vol. 2 Original County Surveyor's Record.