56

COUNTY BUILDING
IN CITY OF BELOIT

PLAT AND RECORD

Of a Survey on Section 4 T 3 R 14 E. of the 4 P. M. in Johnstown Township

Rock County, Wisconsin, made ..... the 19

I hereby certify that the following is a correct record of said survey as made by me.
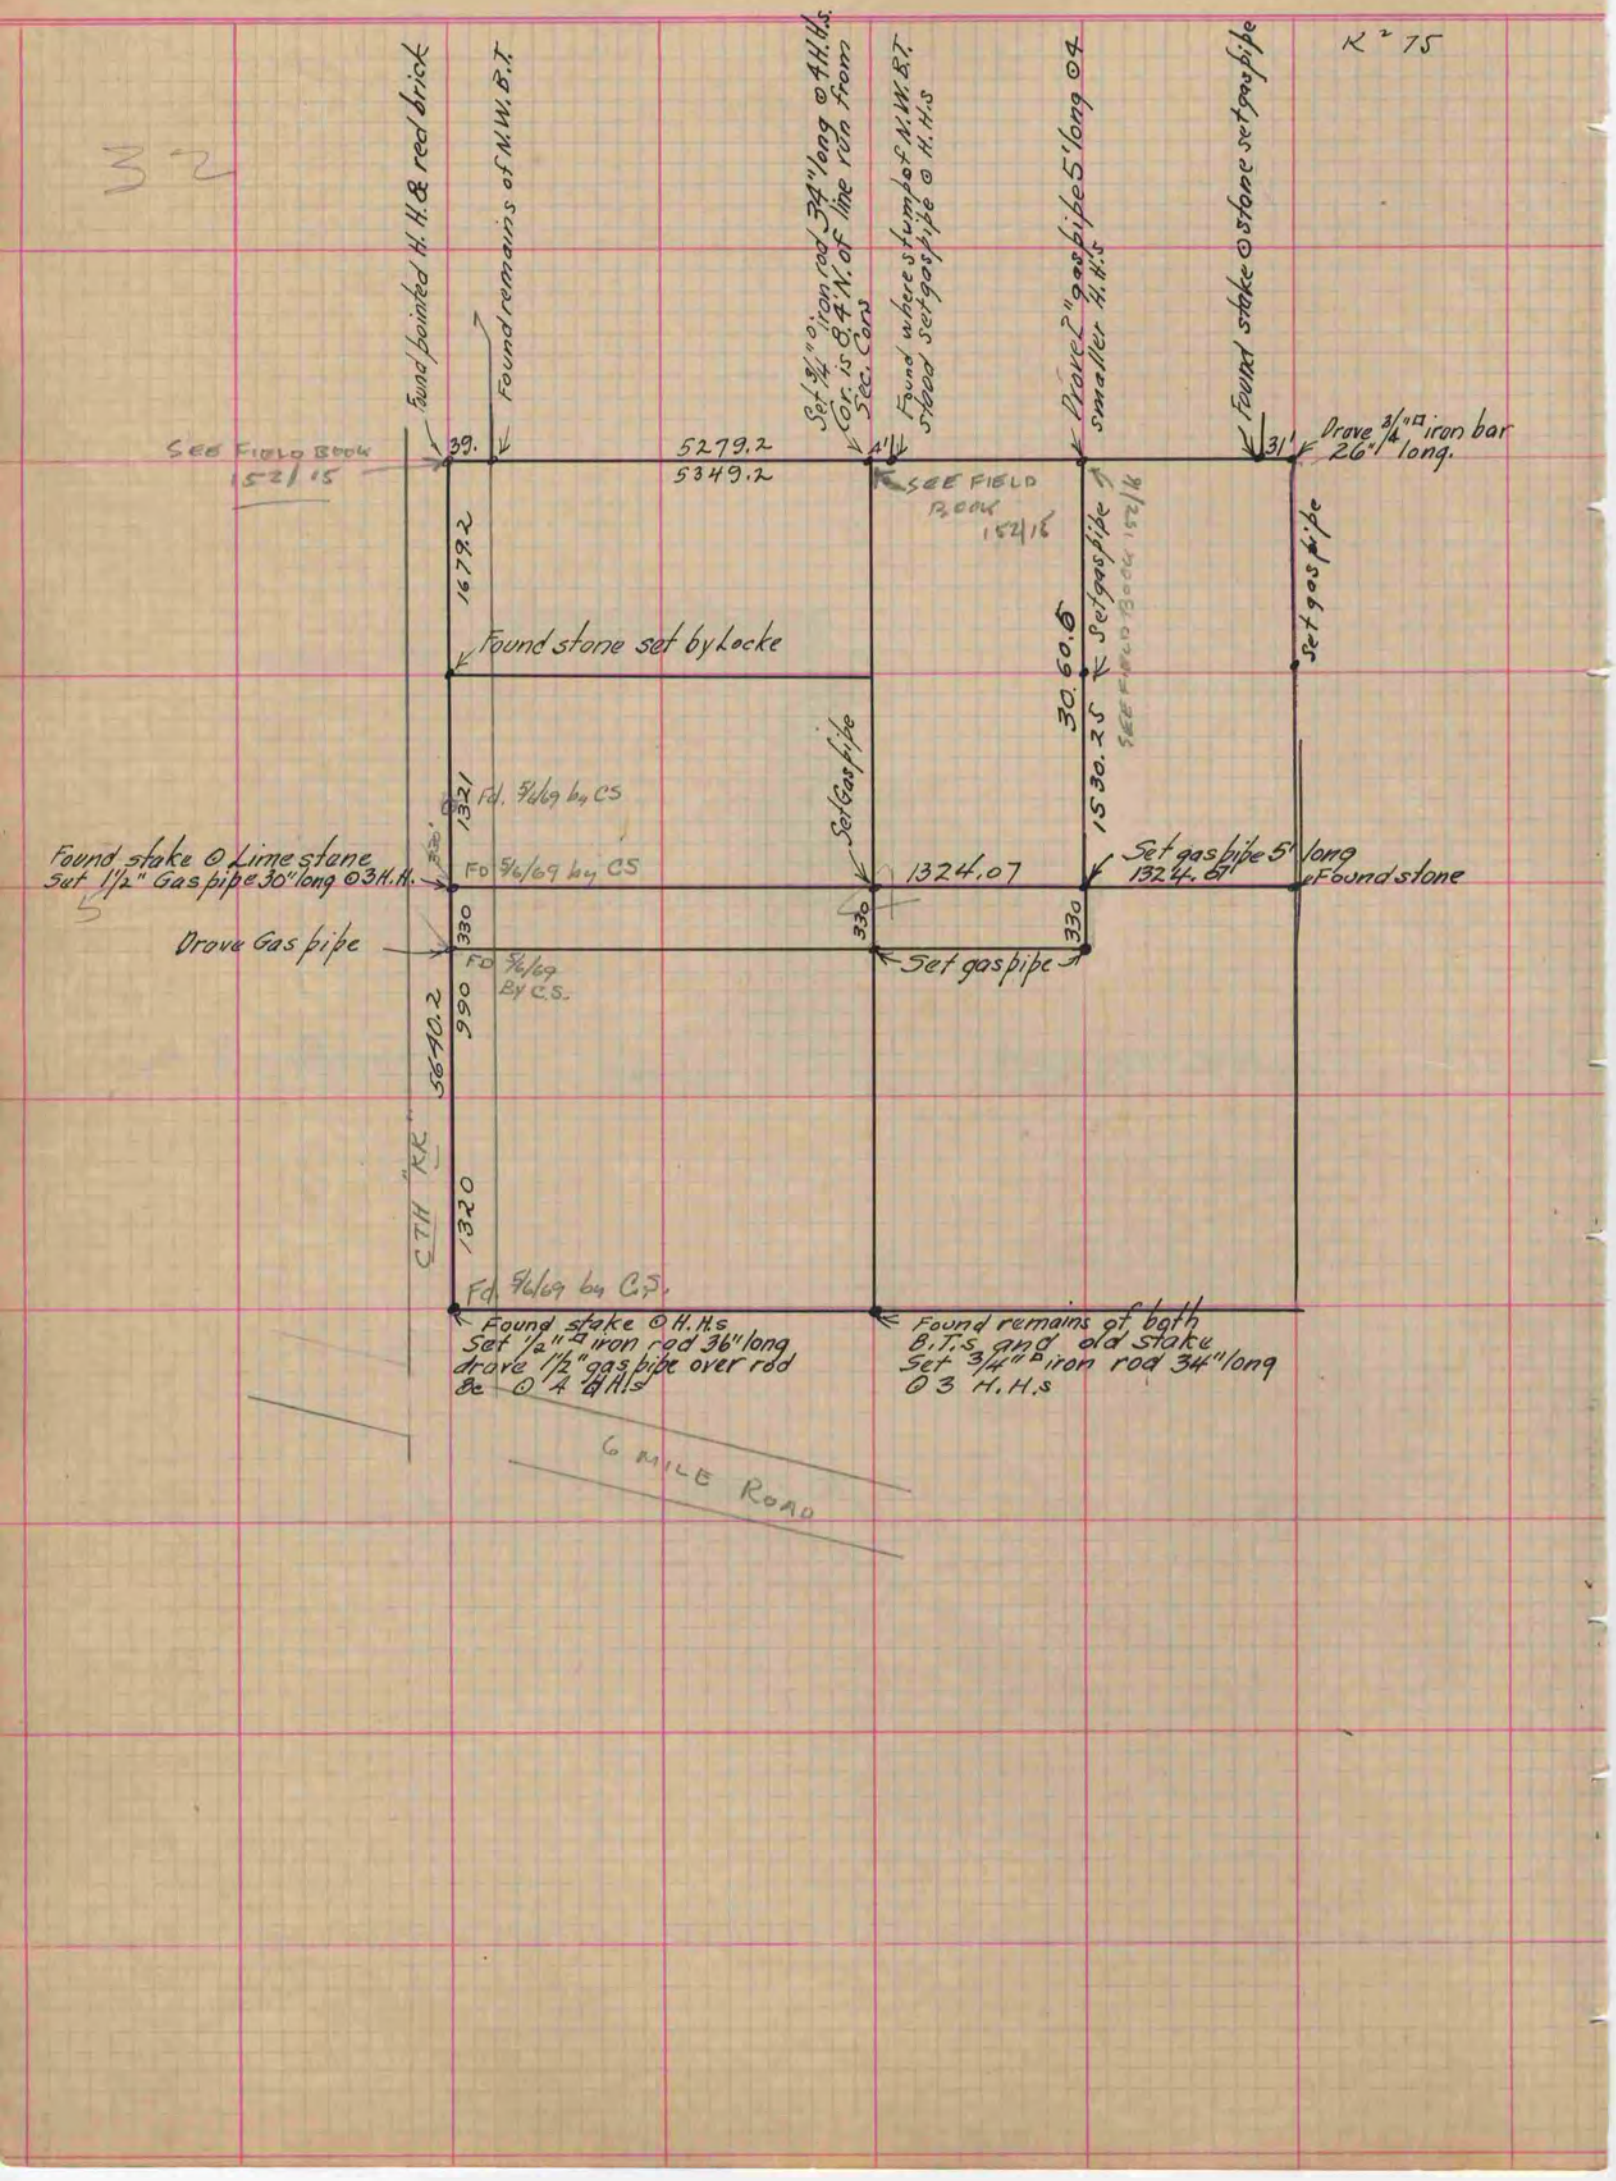
(Signed) C. V. Kerch
R.H.B. County Surveyor.