PLAT AND RECORD

COUNTY BUILDING
IN CITY OF BELOIT

Of a Survey on Section 24 T 2 R 12 E. of the 4 P. M. in Rock Township

Rock County, Wisconsin, made June the 26th 1920

I hereby certify that the following is a correct record of said survey as made by me.

A. H. Bottruan
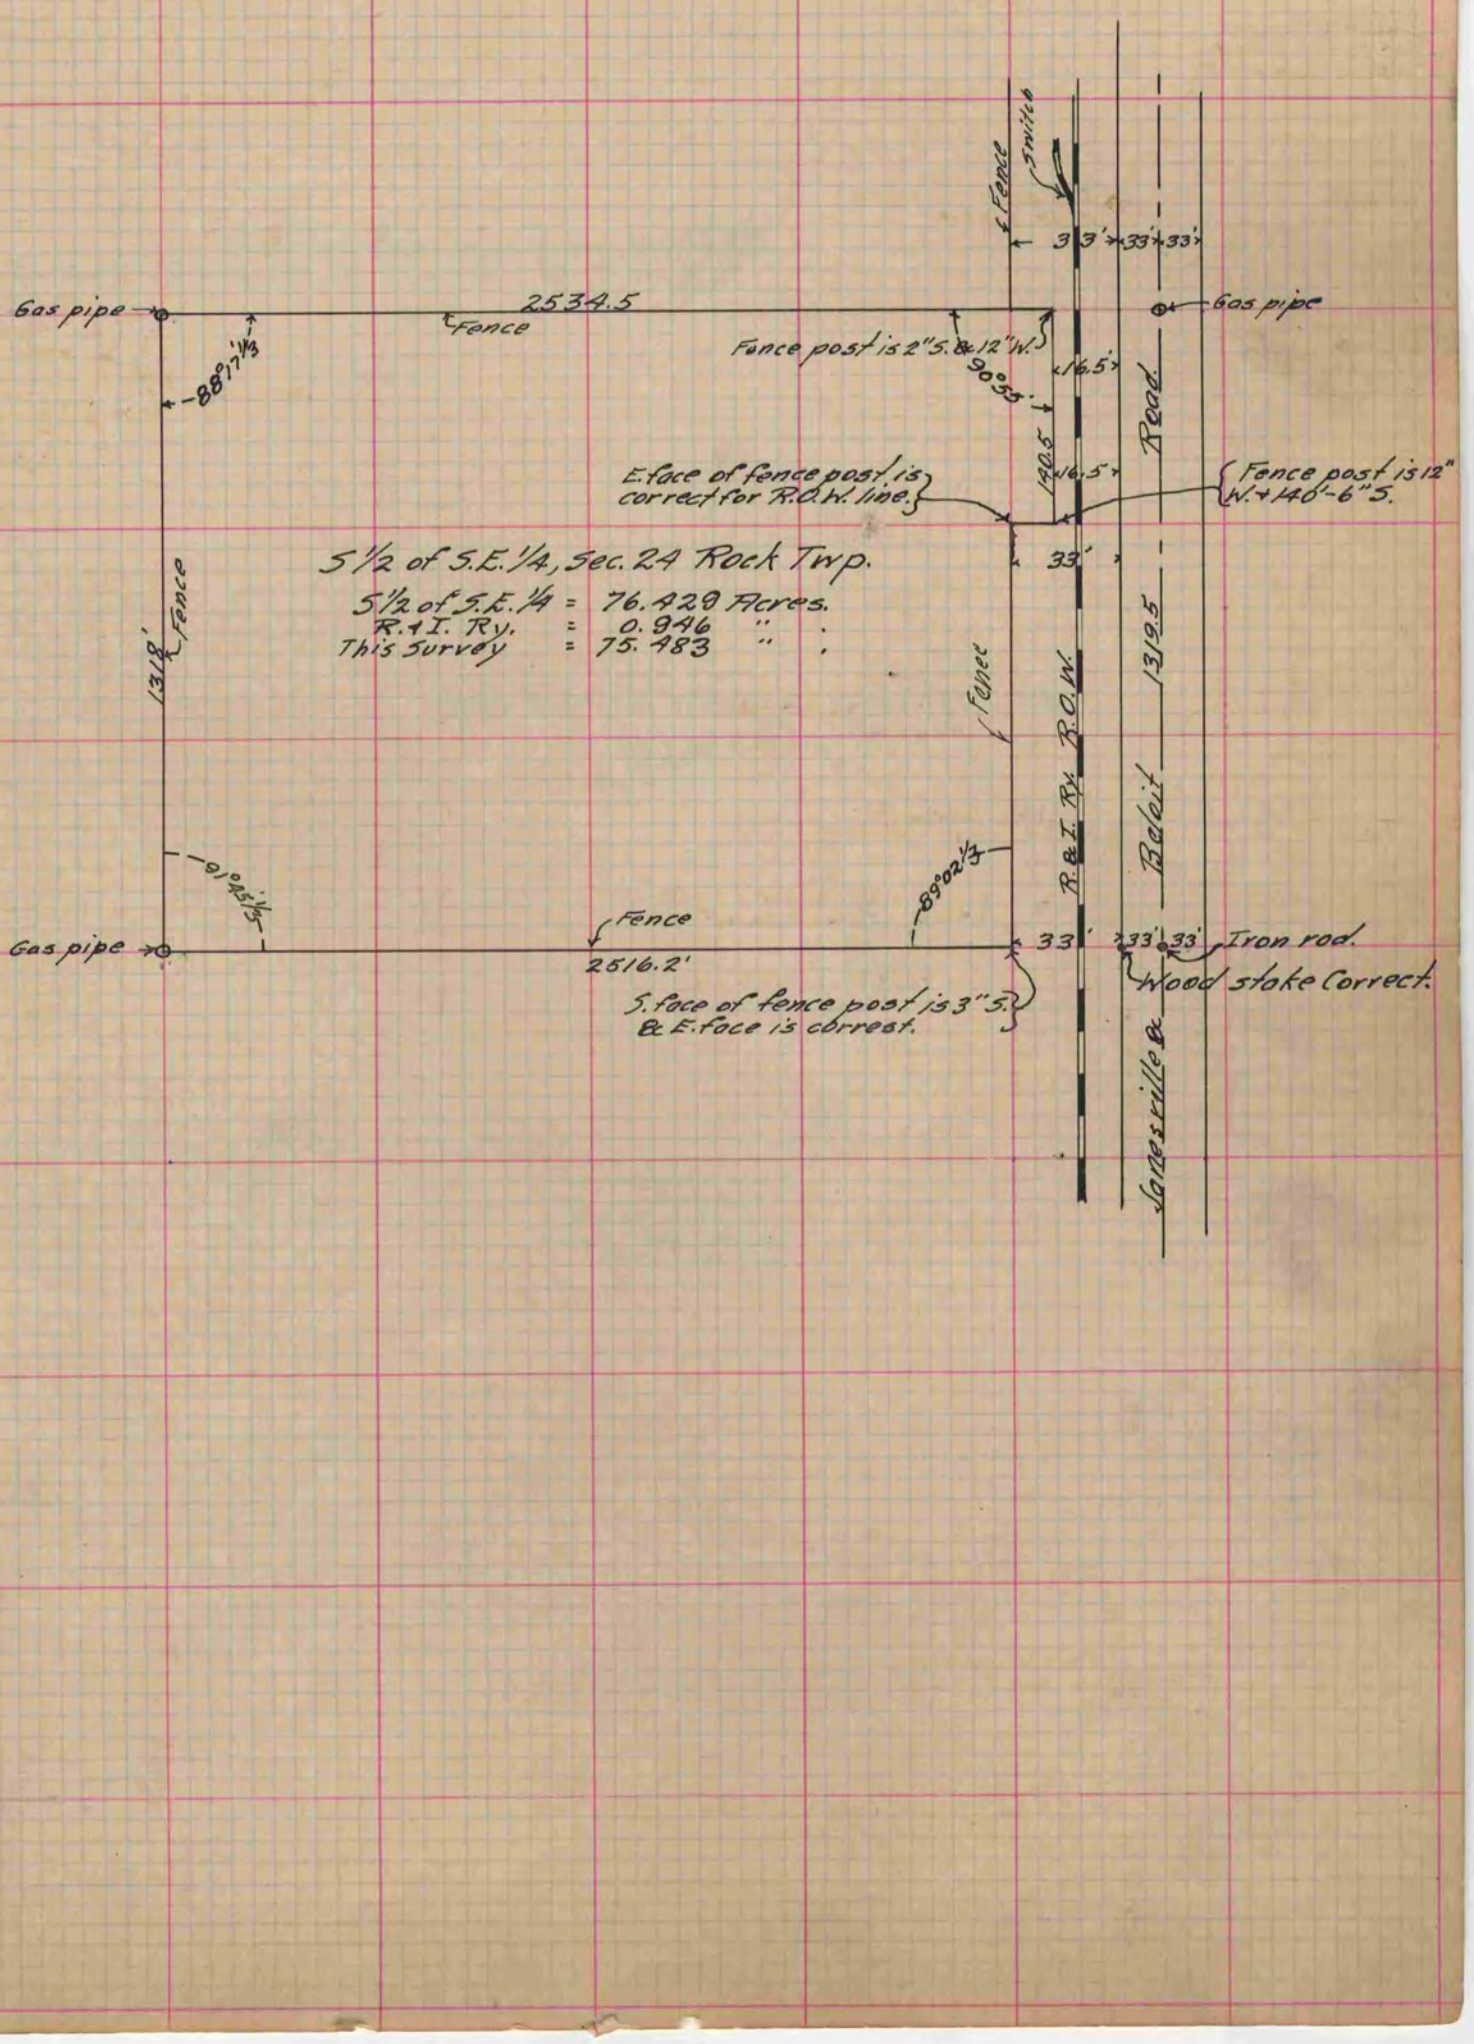
County Surveyor.